




Appendix A

Site Maps of MCC Old Landfills

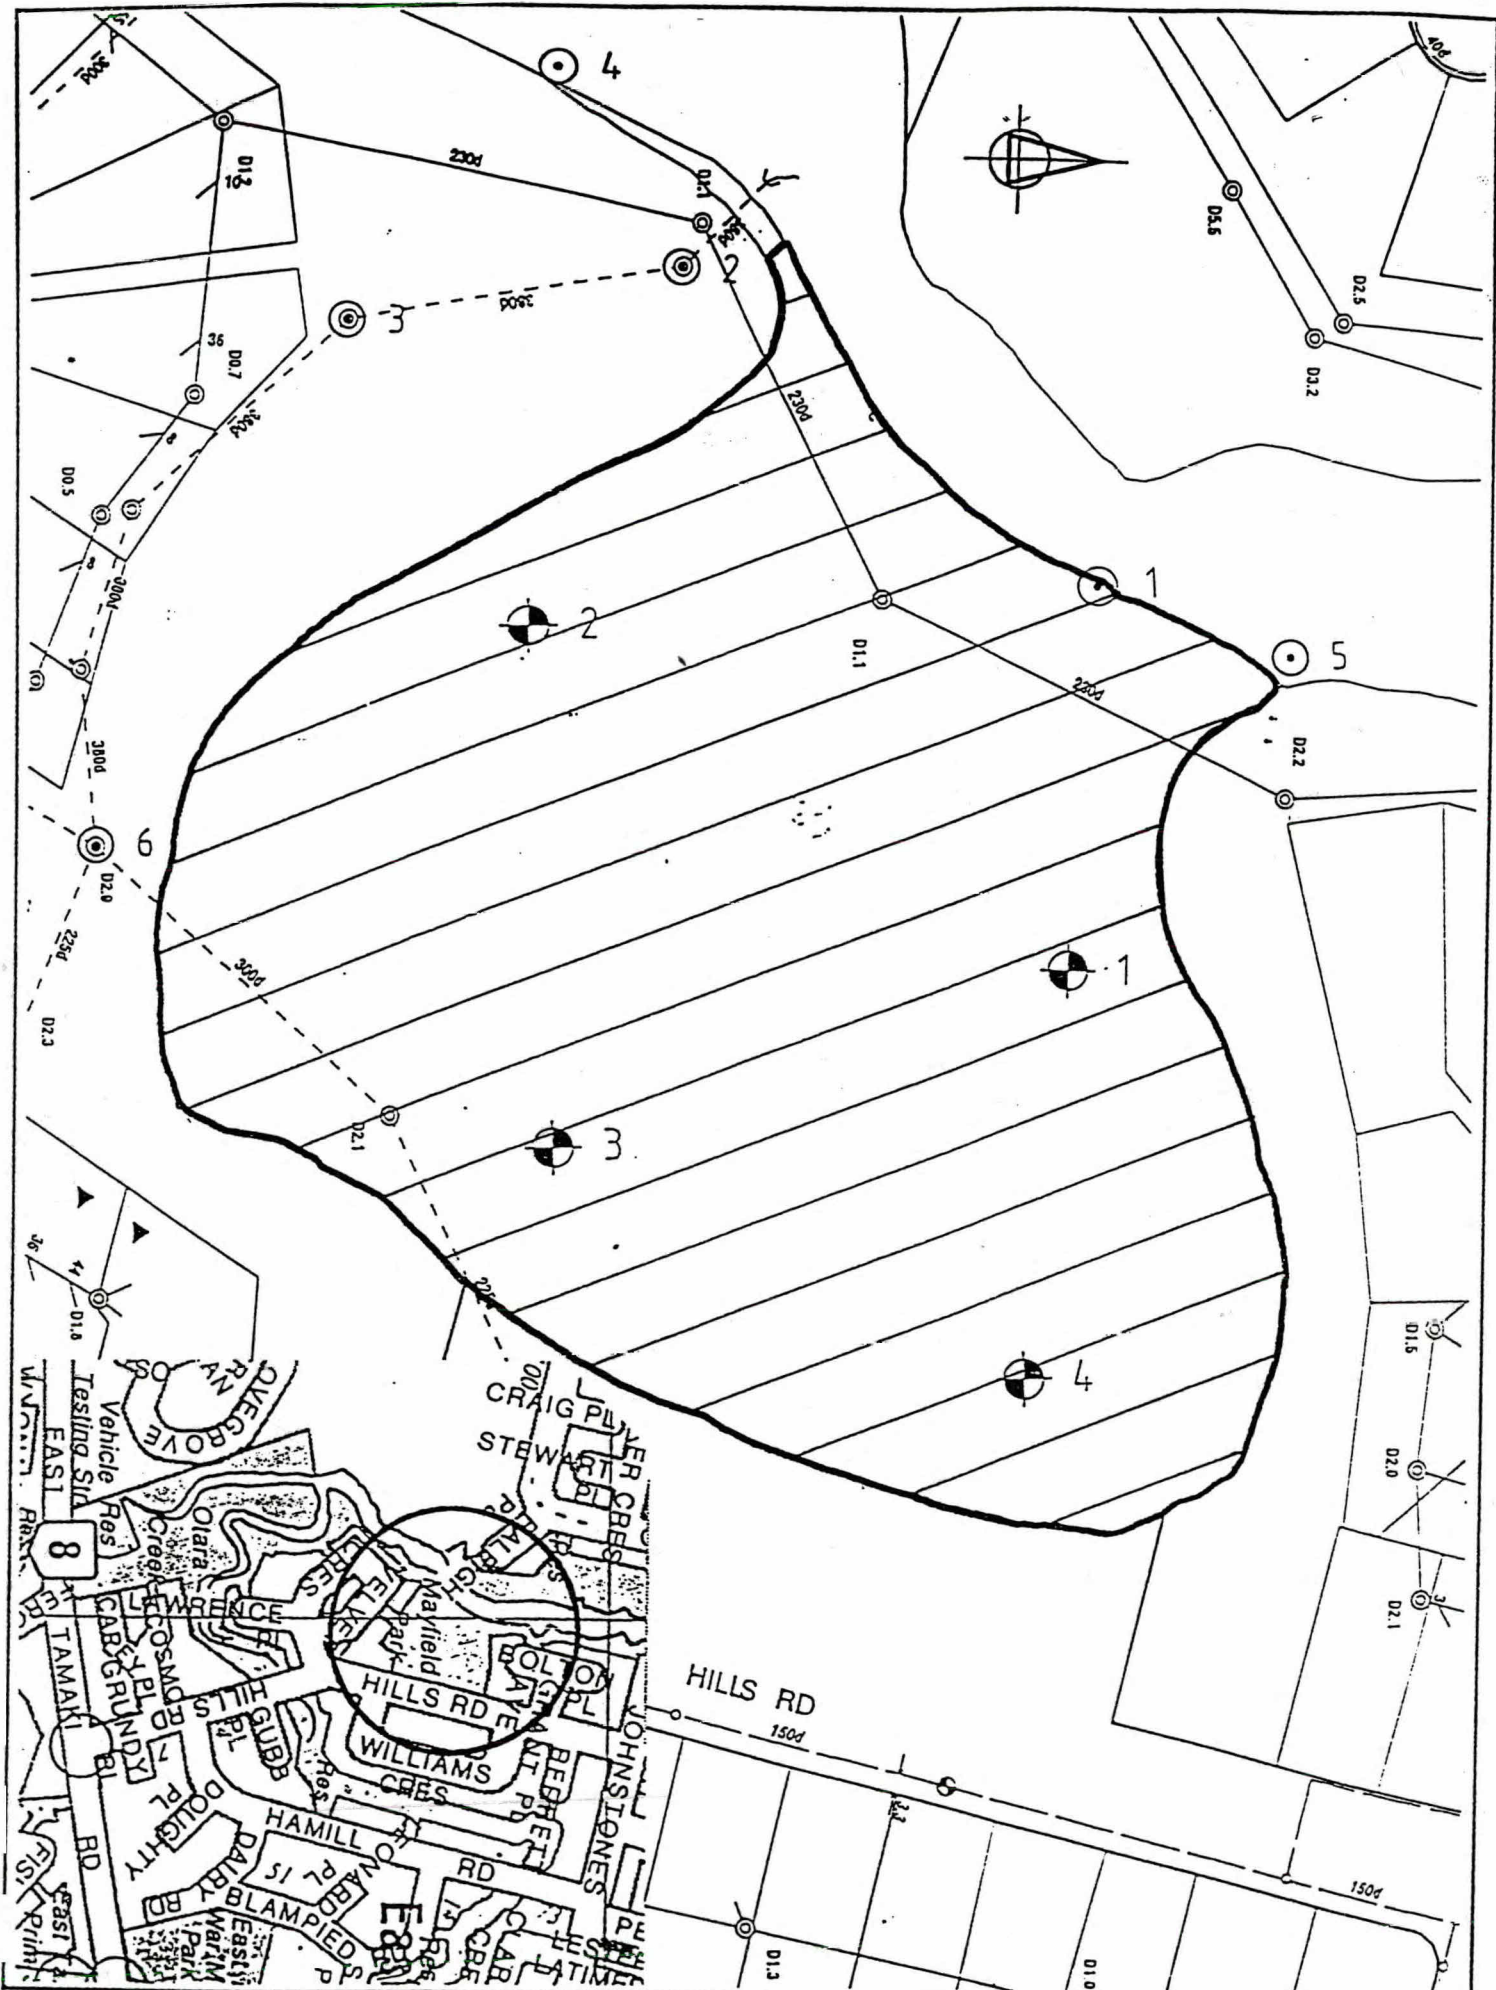


MANKAU
M
 CONSULTANTS
 Consulting Civil & Structural
 Engineers,
 Construction Ltd,
 Project Management,
 Control Documentation
 & Supervision,
 Surveying.
 Telephone (06) 262 8999
 Fax (06) 262 3131

TITLE
HILLS ROAD
WATER SAMPLING LOCATIONS

REV C/OK

	SGMO	DATE
DRAWN	G. Lender	07/98
CHECKED	A. Robinson	07/98
M.C. APPROVED		
DI A11 NO	1	

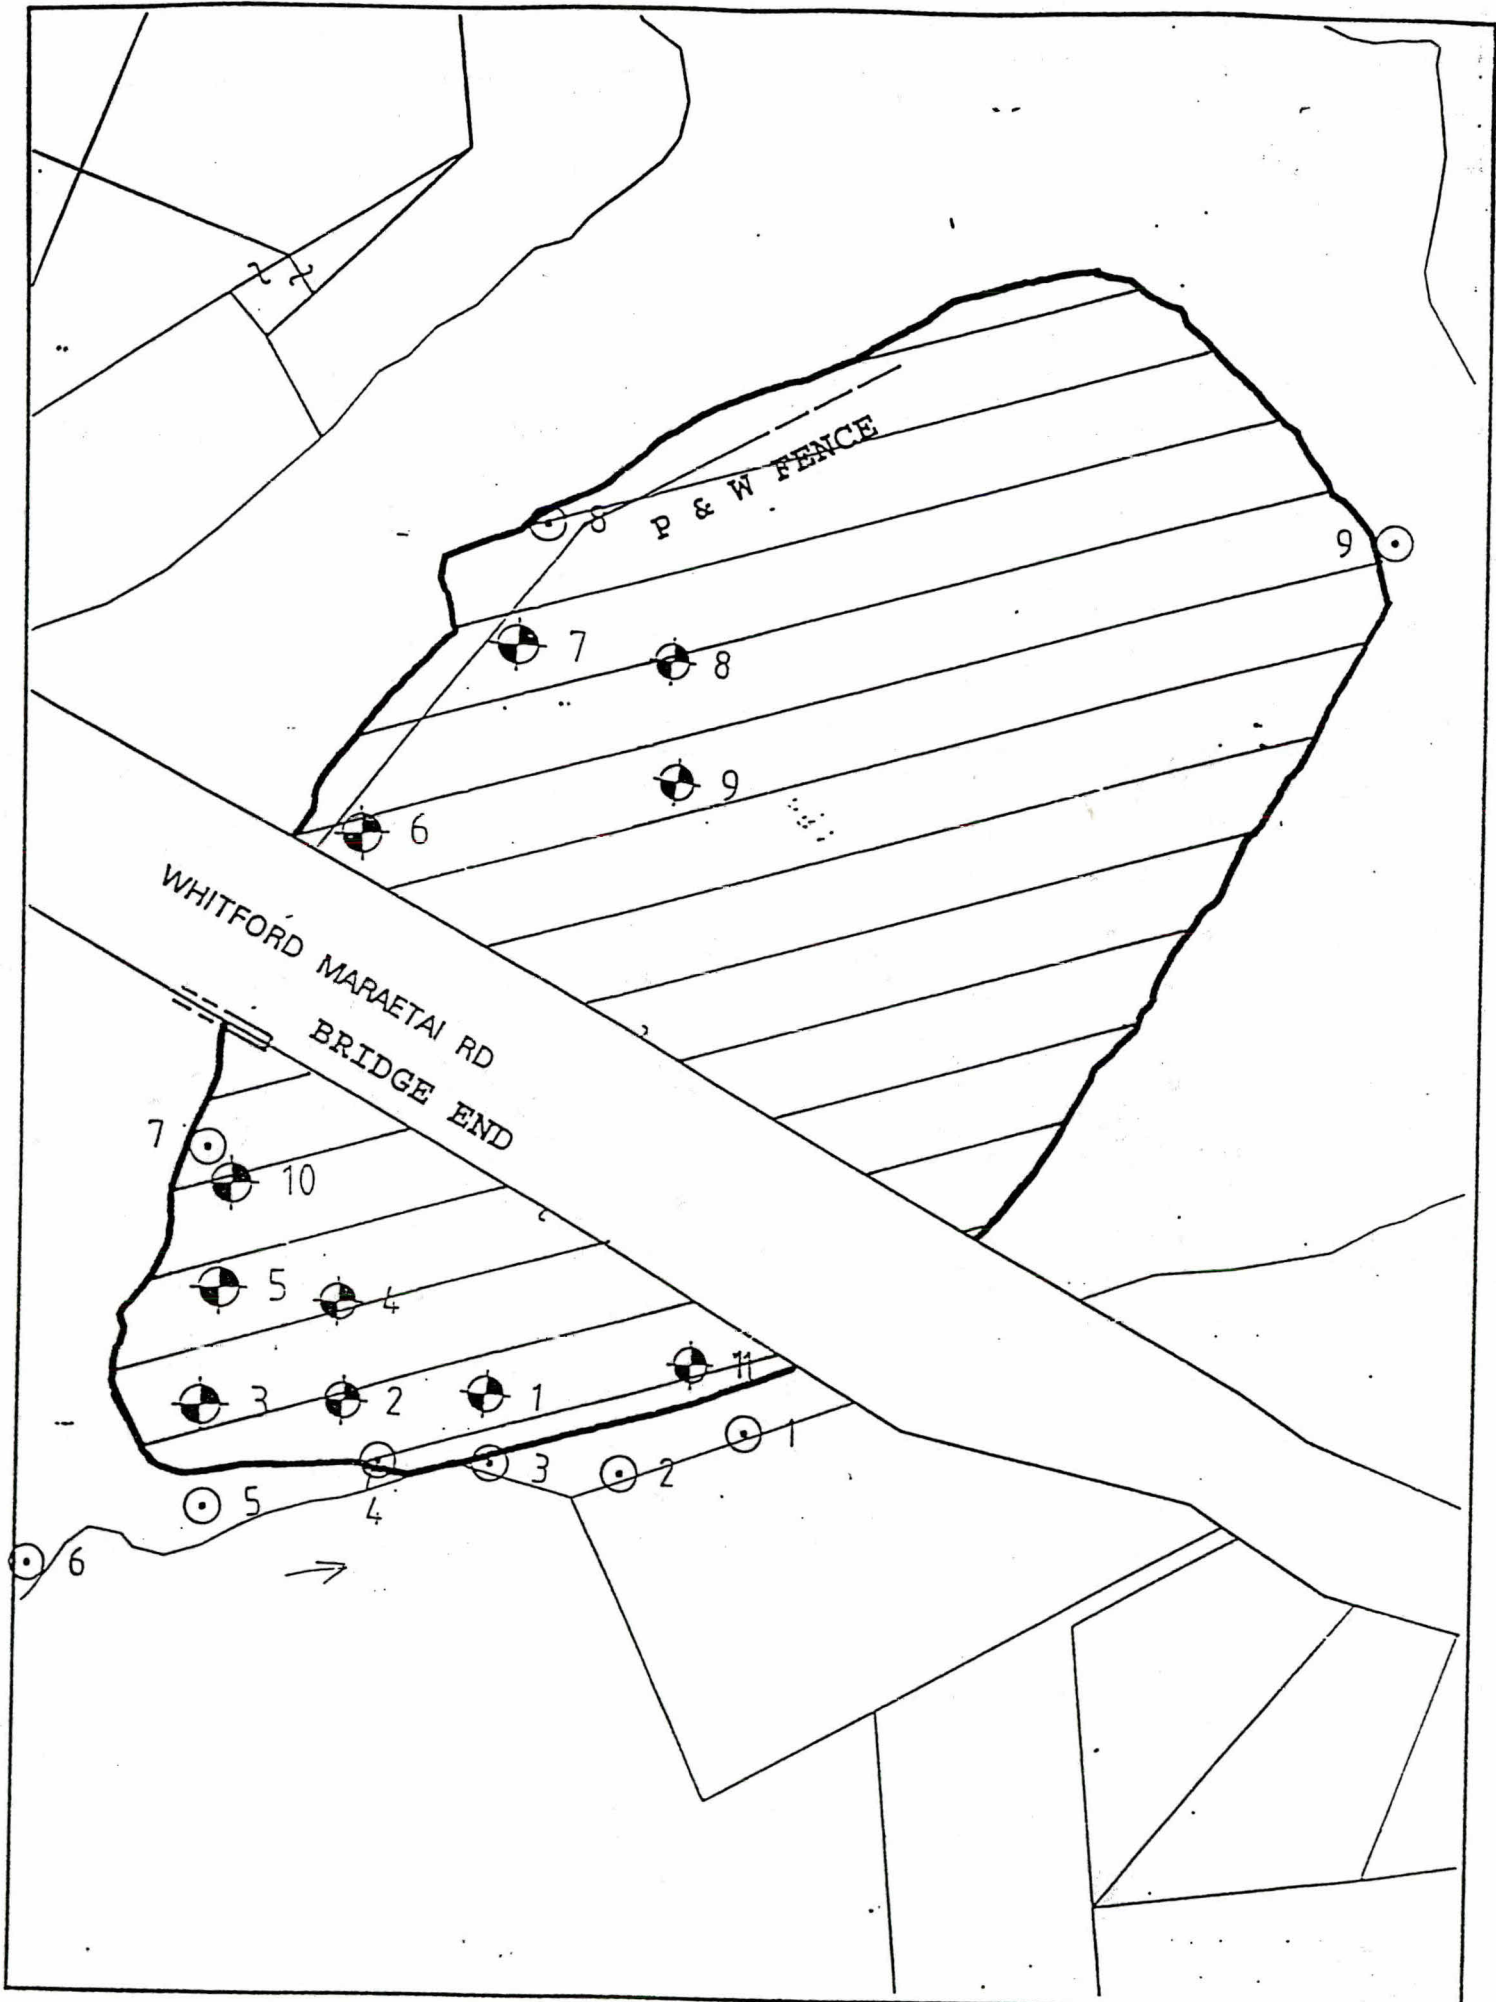

MANGOKU
CONSULTANTS
 Consulting Civil & Structural
 Engineers,
 Geotechnical Lab,
 Project Management,
 Contract Administration
 & Supervision,
 Surveying.
 Telephone (09) 262 8099
 Fax (09) 262 8131

TITLE
WHITFORD BRIDGE
WATER SAMPLING LOCATIONS

REV CHG


	SIGNED	DATE
DRAWN	D. Lender	07/11
CHECKED	A. Robinson	07/11
M.E. APPROVED		

Lot 1, DP 41610 1.1609 ha.

Lot 2 DP 11565 6.5748 ha

TT Lot 1 DP 120852 5.8850 ha.

X

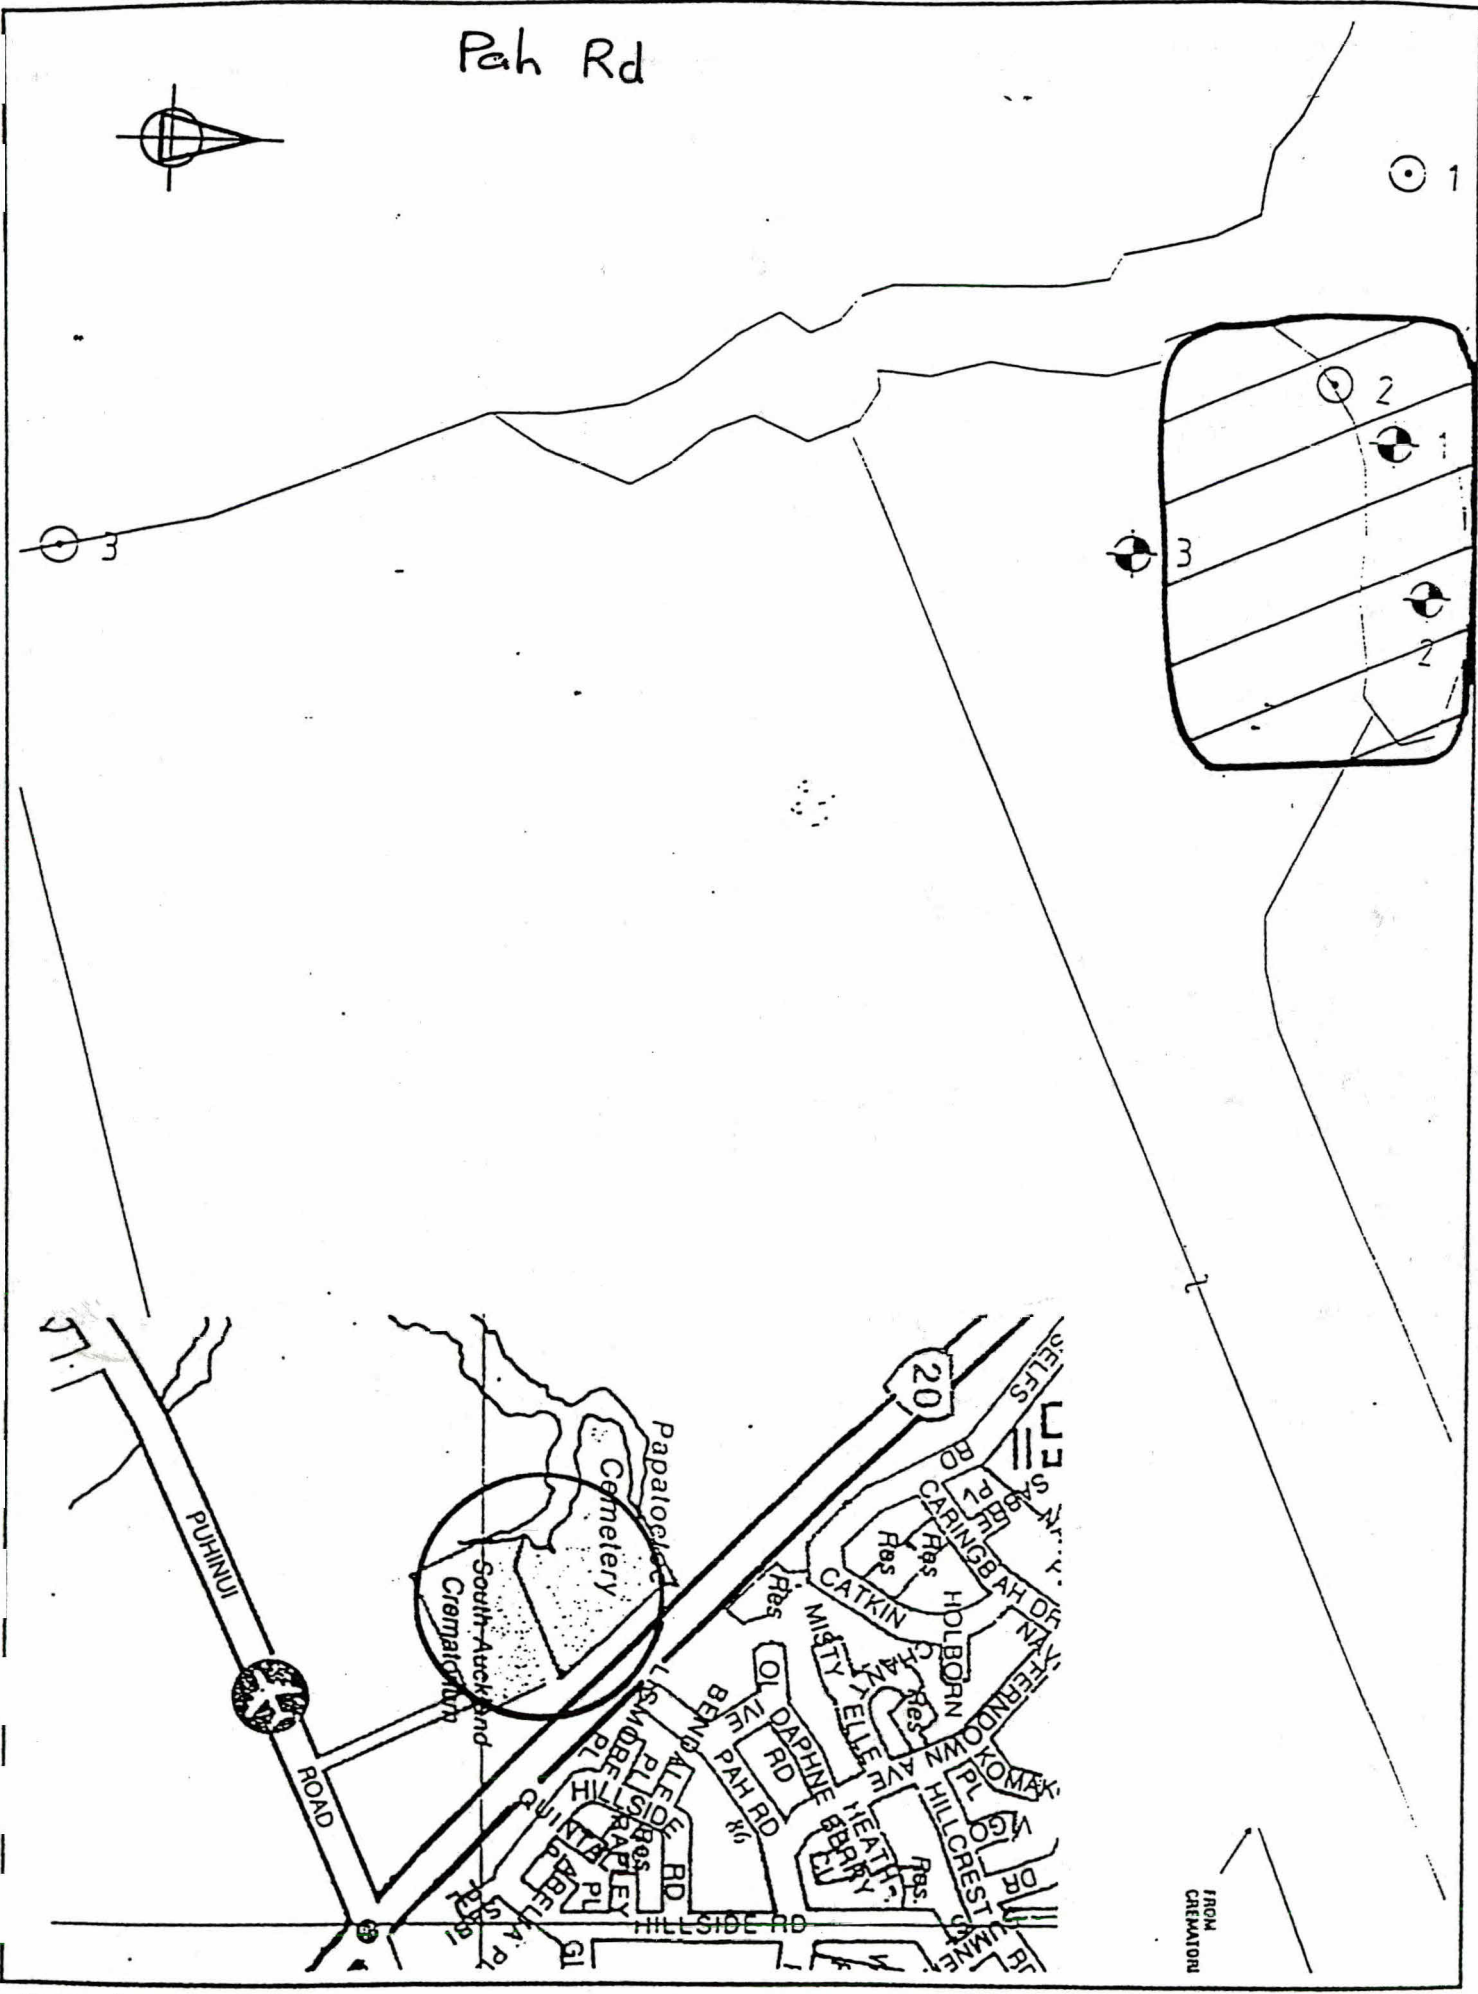

MANUKAU CONSULTANTS
 Consulting Civil & Structural Engineers Ltd.
 Project Management, Control Documentation & Supervision, Surveying.
 Telephone (09) 252 8999
 Fax (09) 252 5131

TITLE
PAPATOETOE CEMETERY WATER SAMPLING LOCATIONS

REV. CHG.

	SCALE	DATE
DRAWN	G. Lander	02/79
CHECKED	A. Robinson	02/79
PL. APPROVED		

Blk 3
Sheet 94

TP
26a, 26b, 26c, 26d.

15 R

Pt Allot 520

7 133 m²

SO 53719

SO 56819

Parish of Monnewa.

1.0317 ha.

✓ Δ


10398 into Detail c.1484

LIR

Shirley Treneary 8828.

Report on all properties (Street Address
(D))

relating to into Detail 10398.

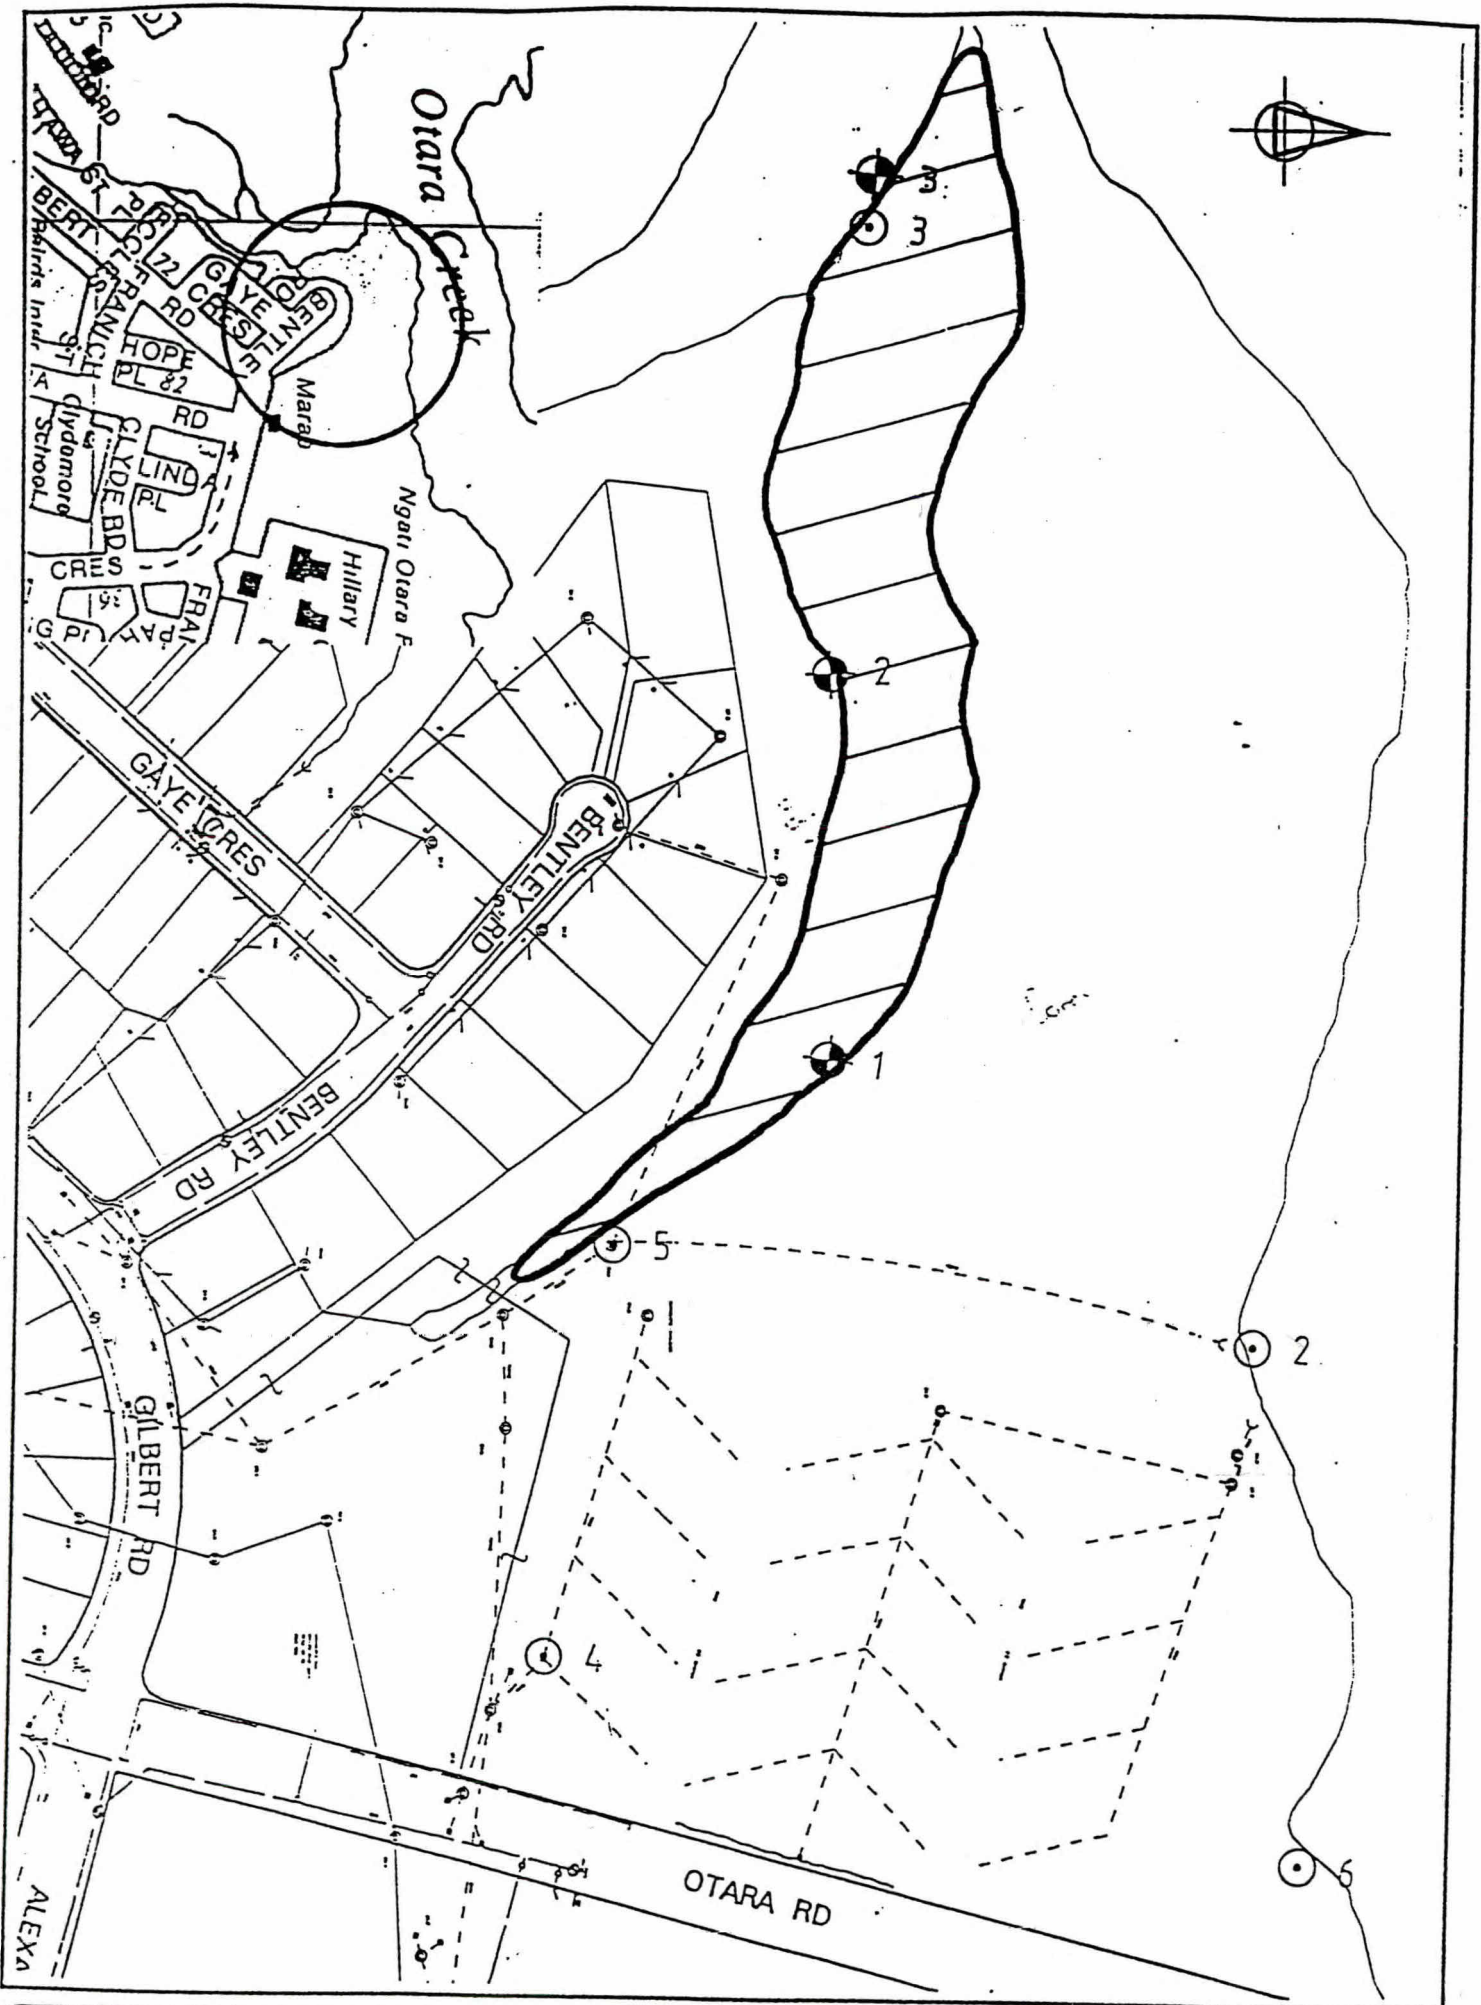

MANGKAU CONSULTANTS
 Consulting Civil & Structural Engineers
 Cost Estimation Ltd.
 Project Management, Contract Documentation & Supervision, Surveying.
 Telephone (09) 252 8999
 Fax (09) 252 2131

TITLE
NGATI OTARA WATER SAMPLING LOCATIONS

REV. CHR

	SCHEM	DATE
DRAWN	D. Lander	02/98
CHECKED	A. Robinson	02/98
M.L. APPROVED		
DI. ANI. MIA		

Blk	Sheet	T ^o
3	88, 89	24C
7	04	


33R Edgewater Drive

Lot 267
DP 54562
4325 m²

Lot 296
DP 54562
7411 m²

✓ Δ

✓ Δ

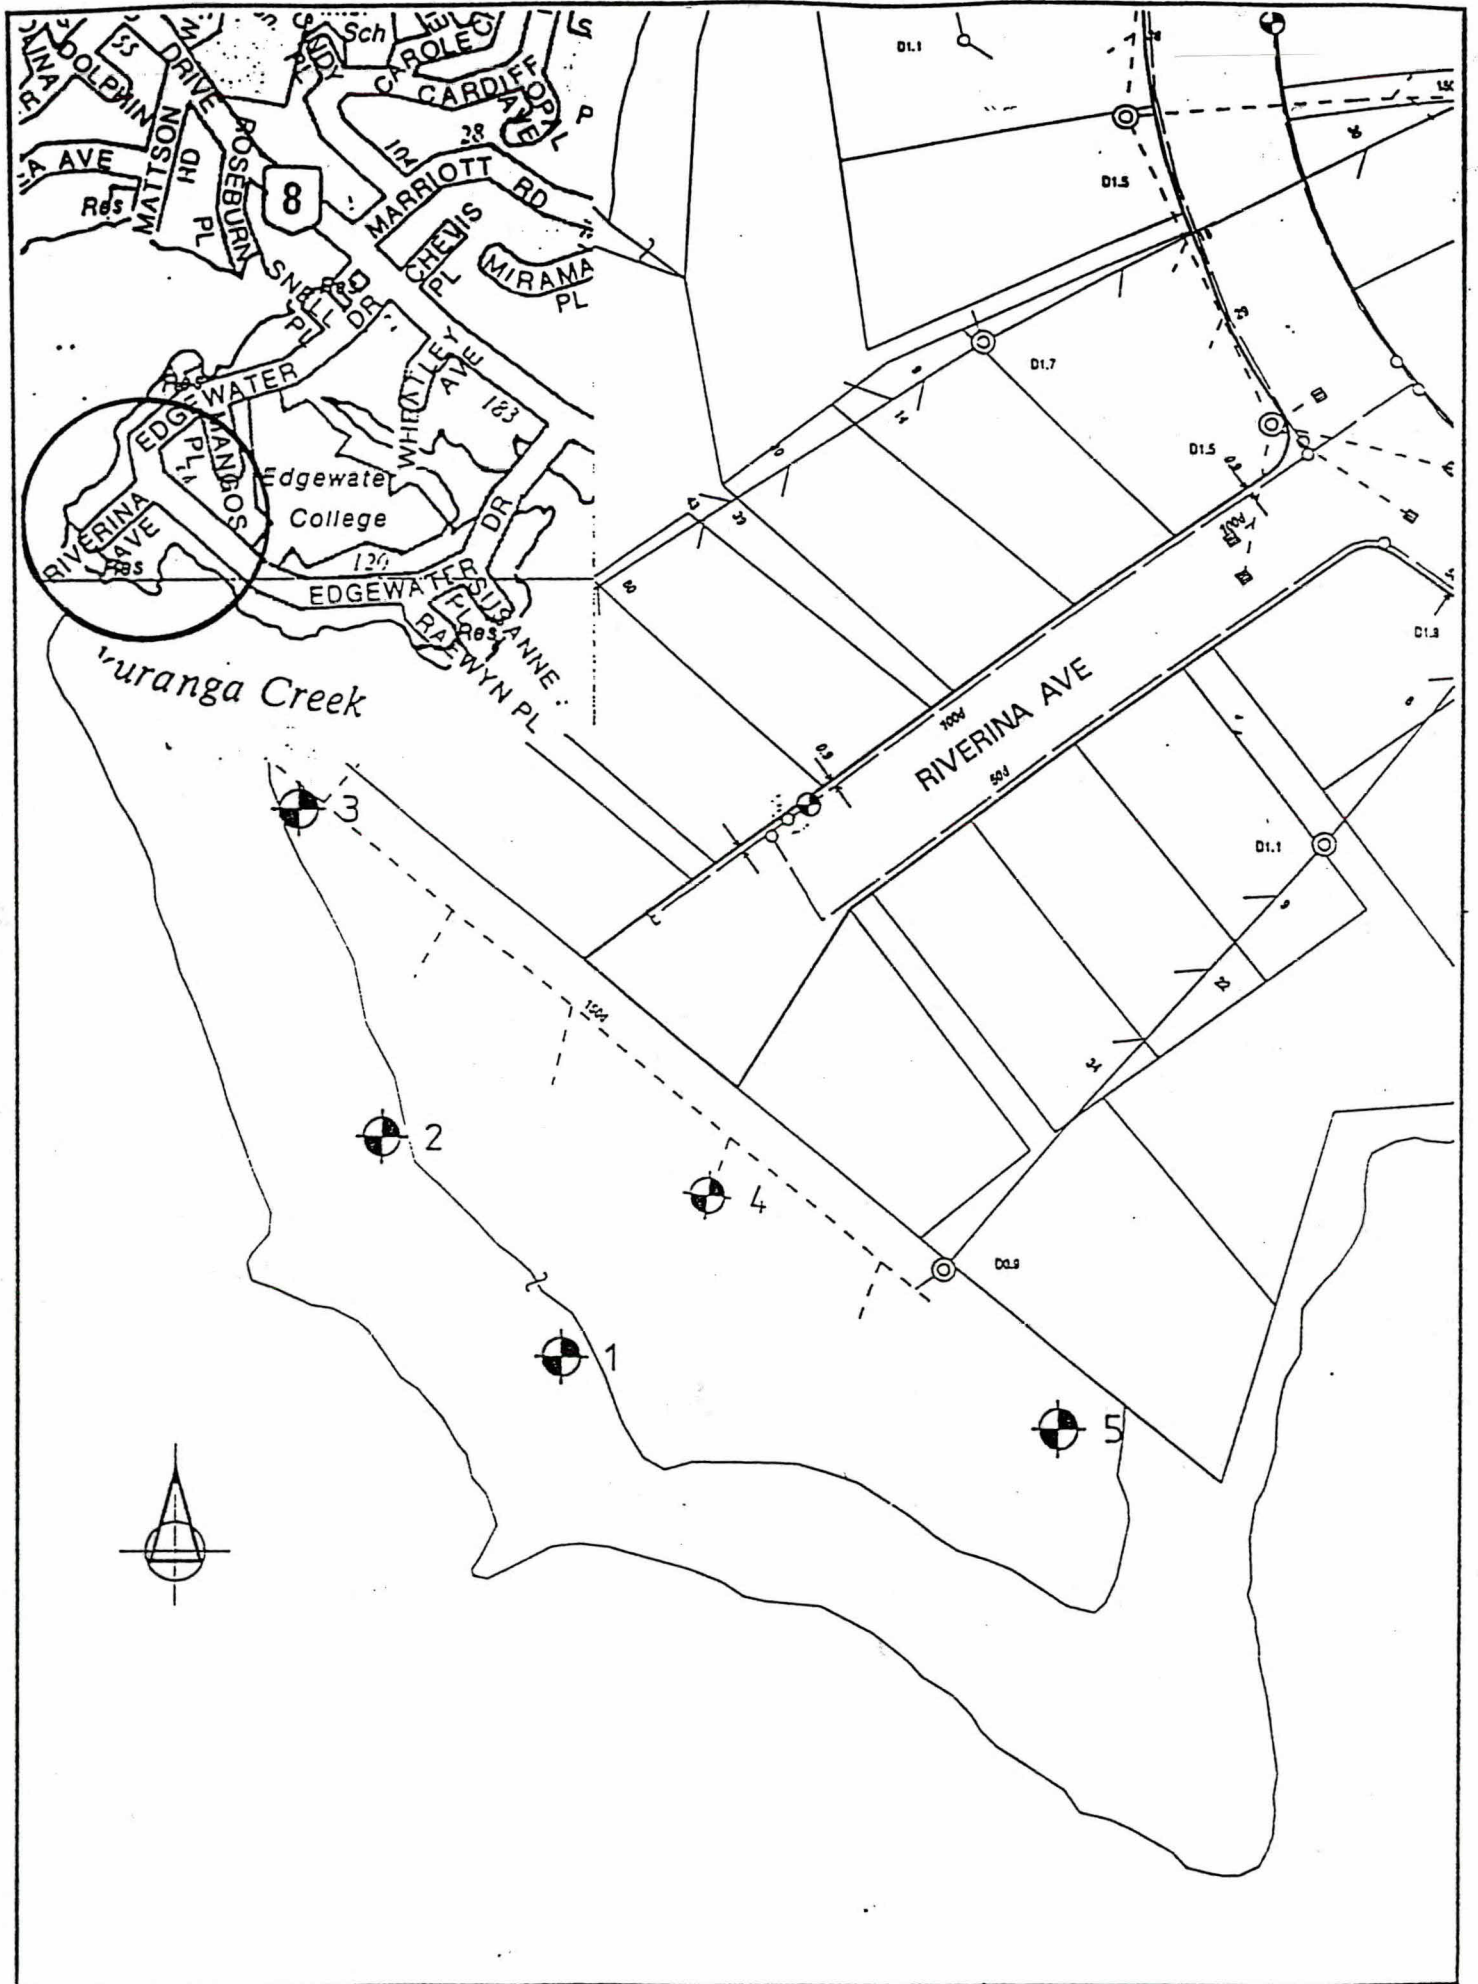

MANGRAU
CONSULTANTS
 Consulting Civil & Structural Engineers
 Geotechnical Lab.
 Project Management
 Contract Administration & Supervision
 Surveying
 Telephone (06) 262 8011
 Fax (06) 262 8113

TITLE: **RIVERINA AVENUE WATER SAMPLING LOCATIONS**

REV: **CMR**


	SIGNED	DATE
DRAWN	D. Lander	02/98
CHECKED	A. Robinson	02/98
M.E. APPROVED		
PLAN NO 5		

Blk 7

Sheet 13, 14, 15, 16

TP 23d, 24b, 24d

SO	51501	1.4282 ha.	Δ ✓
Lot 109	A.P 52077	6528 m ²	x
Lot 108	AP 52077	2.0520 ha.	x

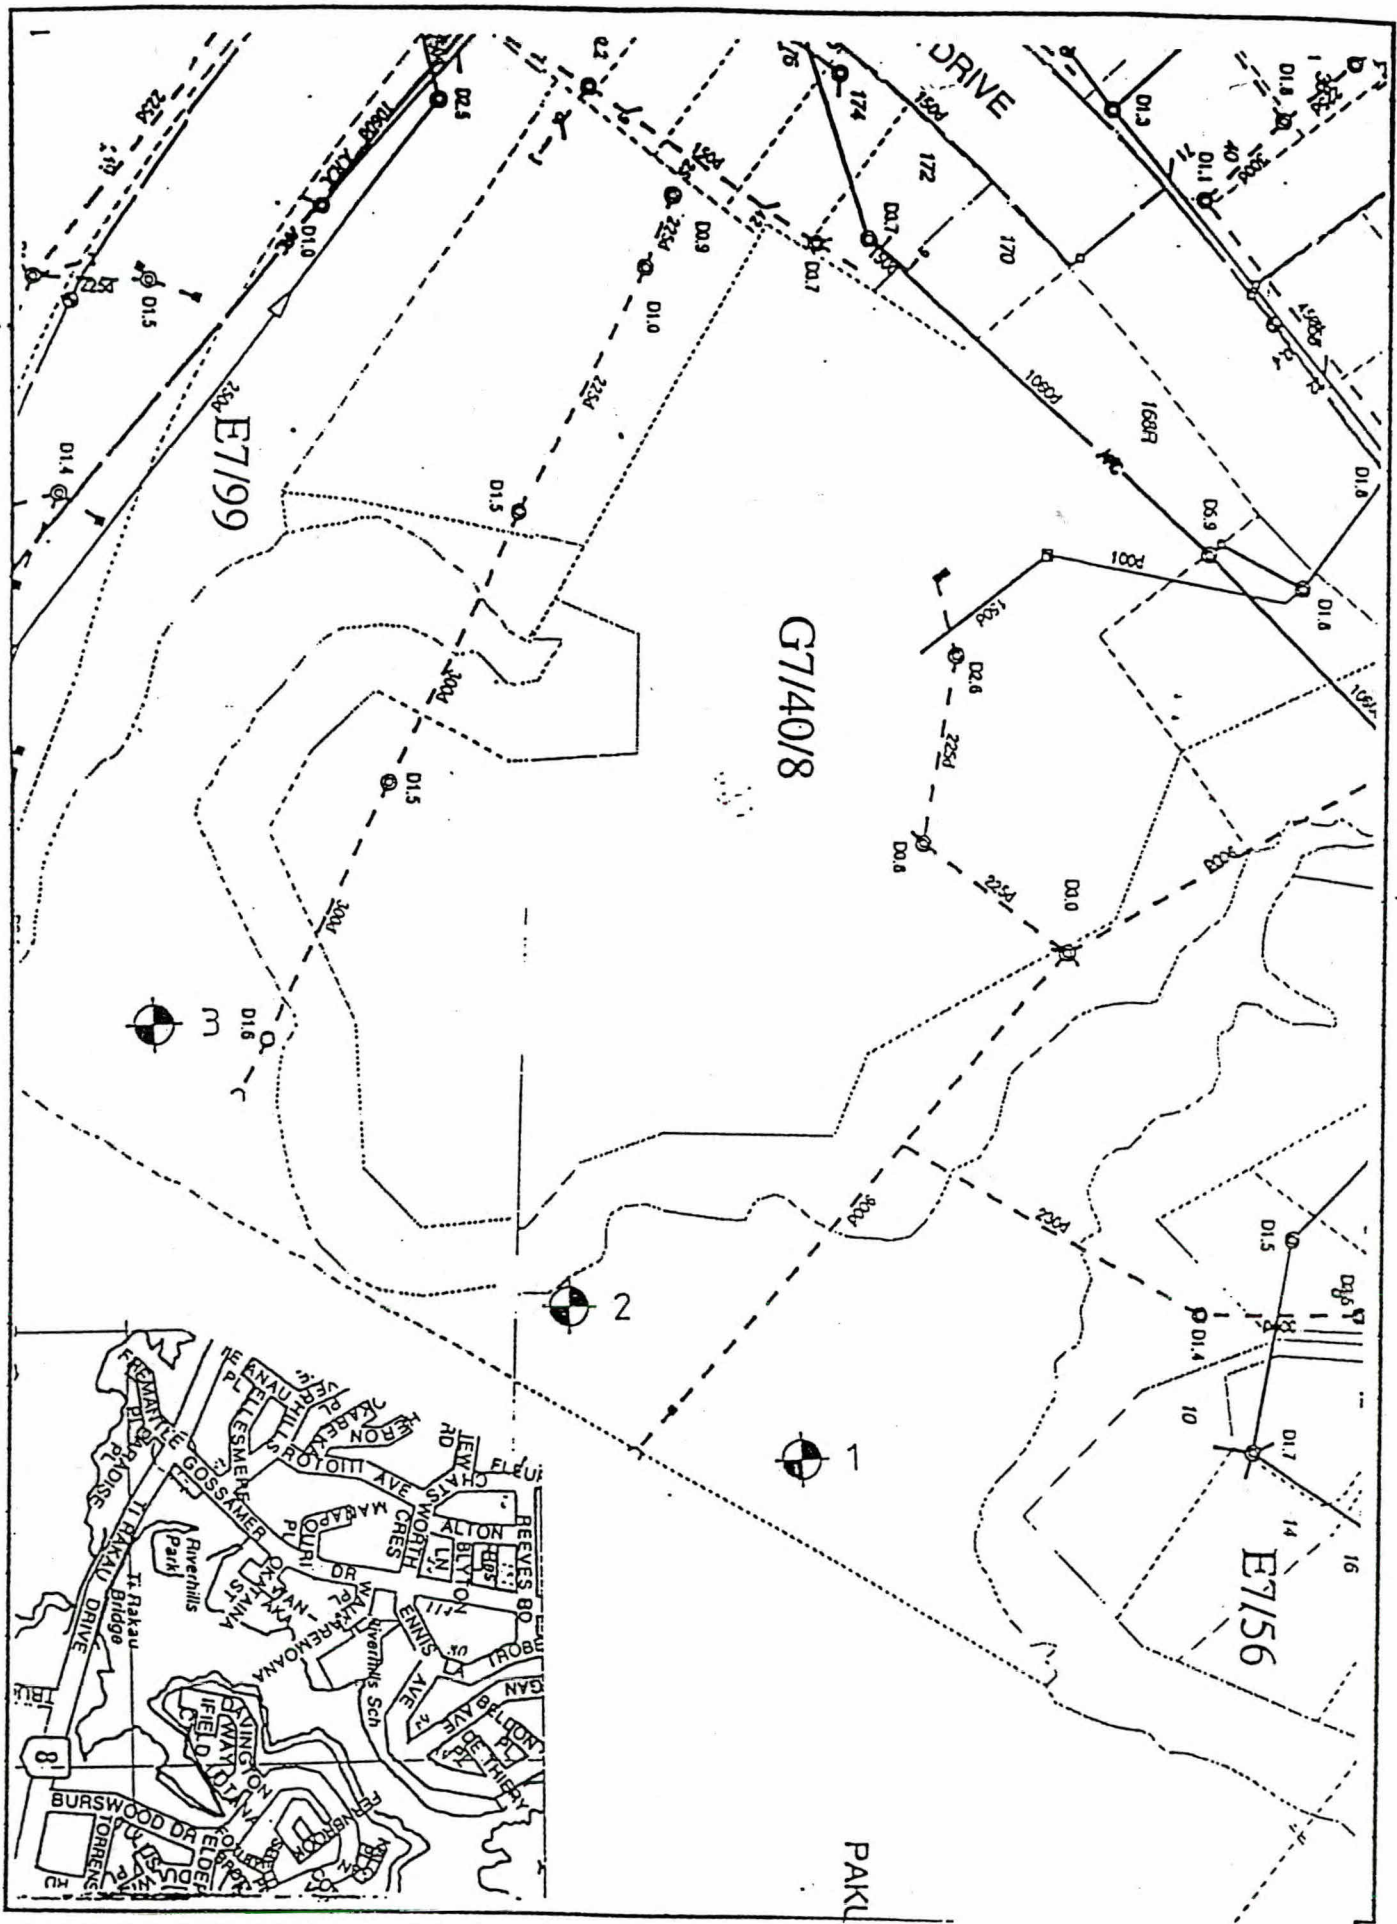

MANUKAS
CONSULTANTS
 Civil, Geotechnical & Structural
 Engineering, Land
 Project Management,
 Contract Administration
 & Supervision,
 Surveying

Telephone (06) 262 8994
 Fax (06) 262 8131

TITLE
**RIVERHILL PARK
 WATER SAMPLING LOCATIONS**

REV. 01


NO.	ISSUED	DATE
DRAWN	B. Lander	02/08
CHECKED	A. Robinson	02/08
M.C. APPROVED		
PLAN NO. 6		


B/K Sh. TP
9 16, 17 30d

SOR

Lot 1 DP 51364
3.6949 ha.

△ ✓

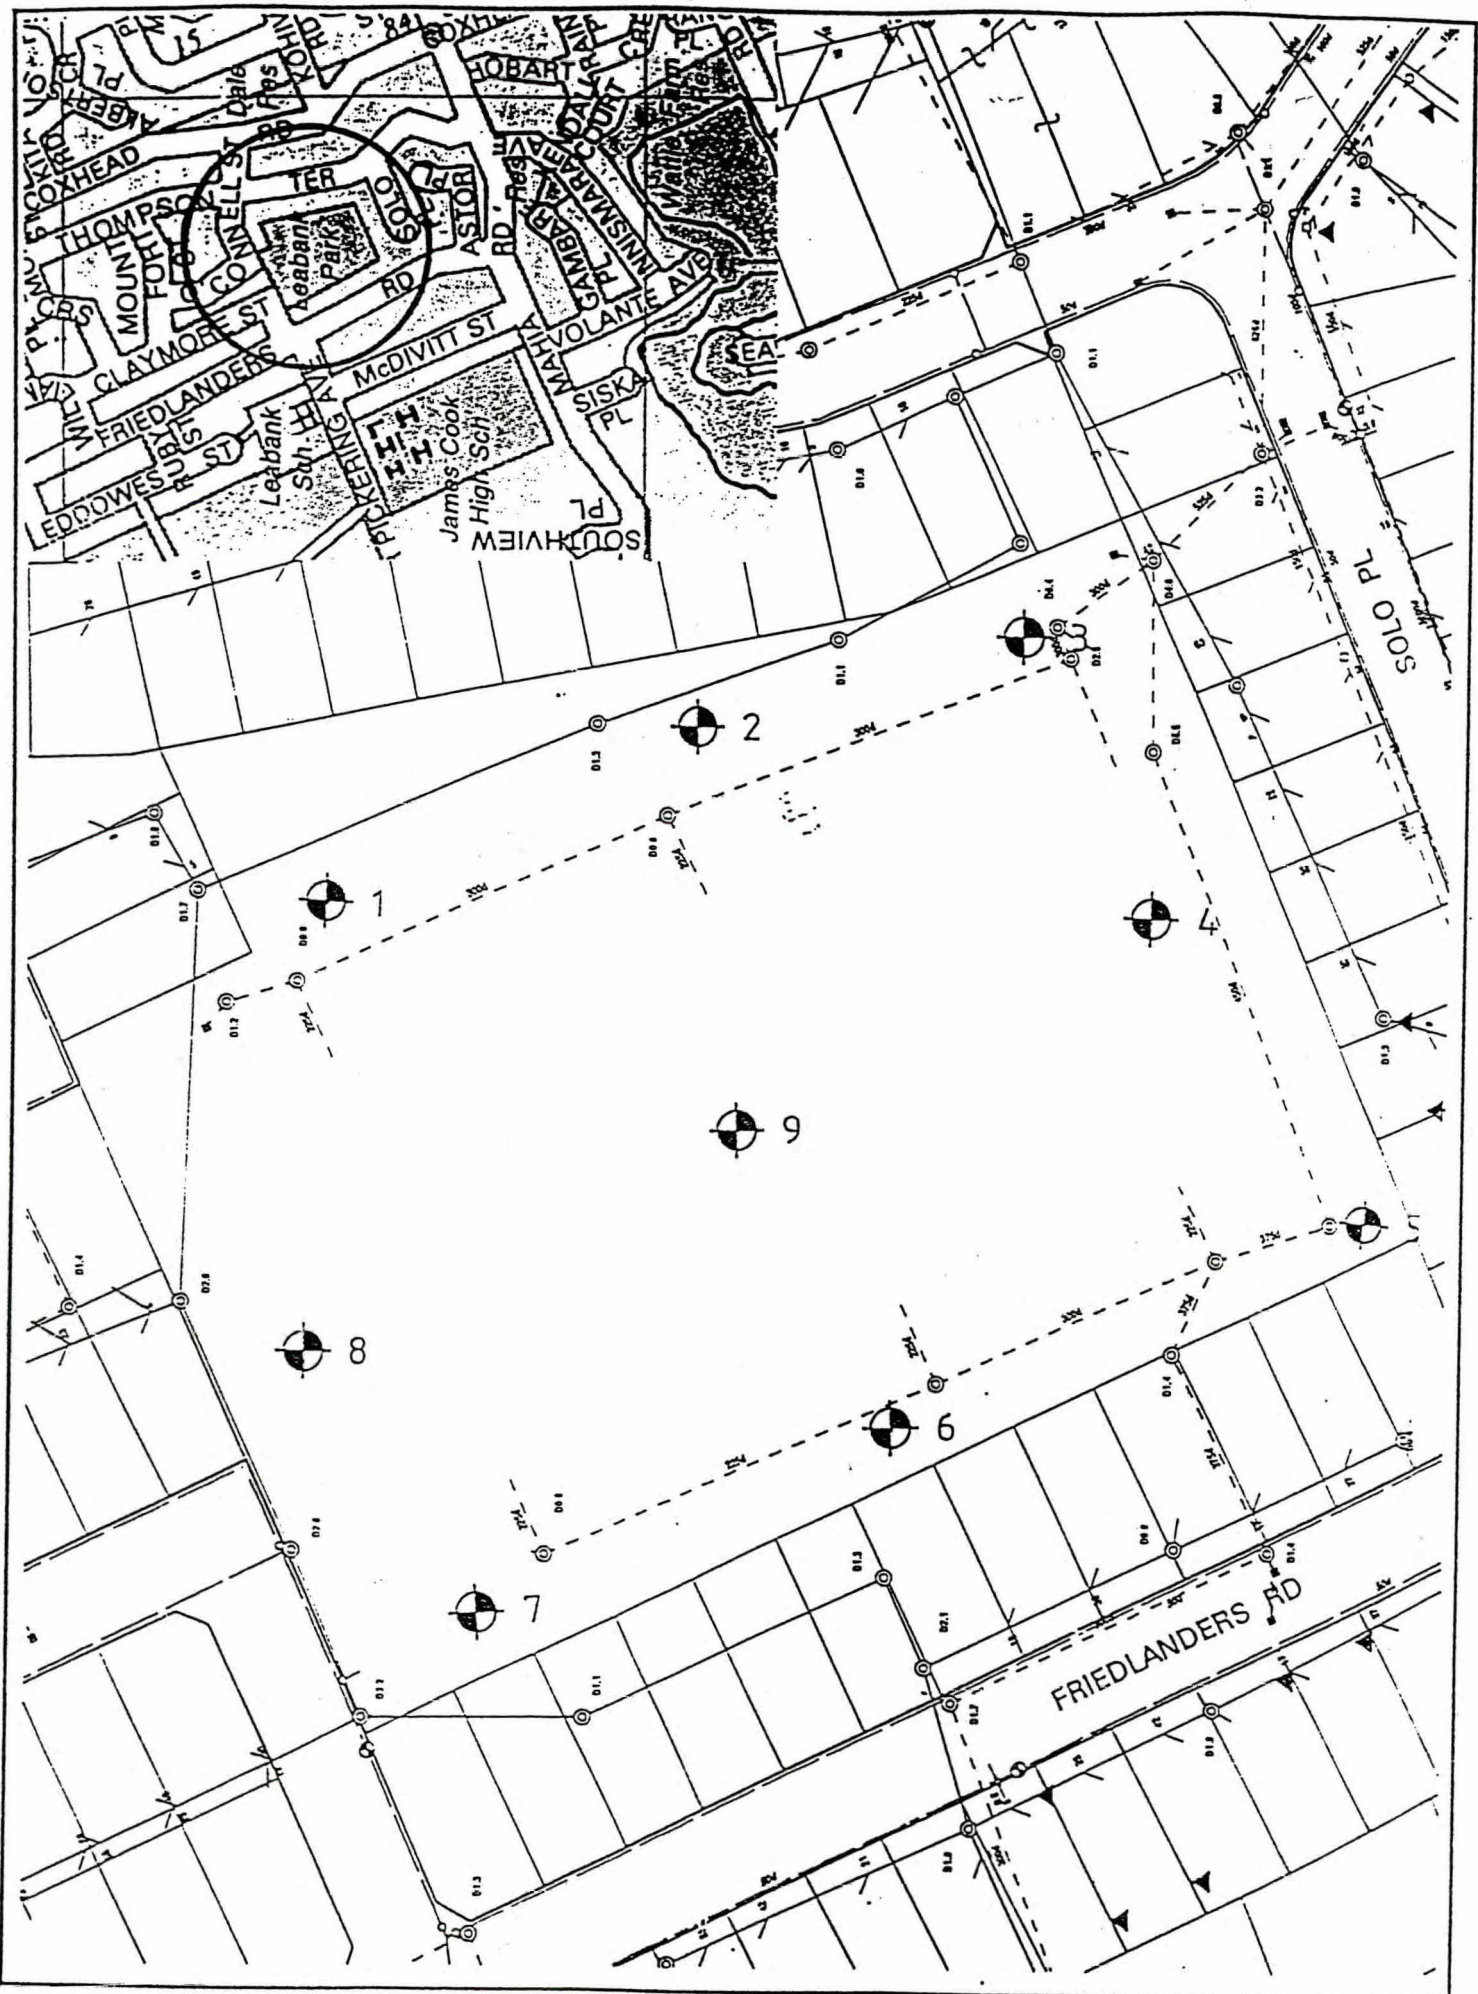

MANUKAU

 Consulting Civil & Structural Engineers
 Geotechnical Ltd.
 Project Management
 Contract Documentation & Supervision
 Surveying
 Telephone (06) 252 8995
 Fax (06) 252 513

TITLE
**LEABANK PARK
 WATER SAMPLING LOCATIONS**
 REV CHA

SCALE		DATE
DRAWN	G. Leader	02/10
CHECKED	A. Robinson	02/10
M.C. APPROVED		
D.L.A.		

B/K.

Sh.

TP

01

~~81, 92, 93~~

10a 10c 5d.

At See 1 B/k U Otahuhu SD.

SD 56622 2.0670 ha

0.3213

Δ ✓

Δ ✓

See 14

SD 56538

610 m²


B/K.
03

Sh.
~~86,87~~

TP
23c

sec 1 SD 52269
9740m²

Δ ✓

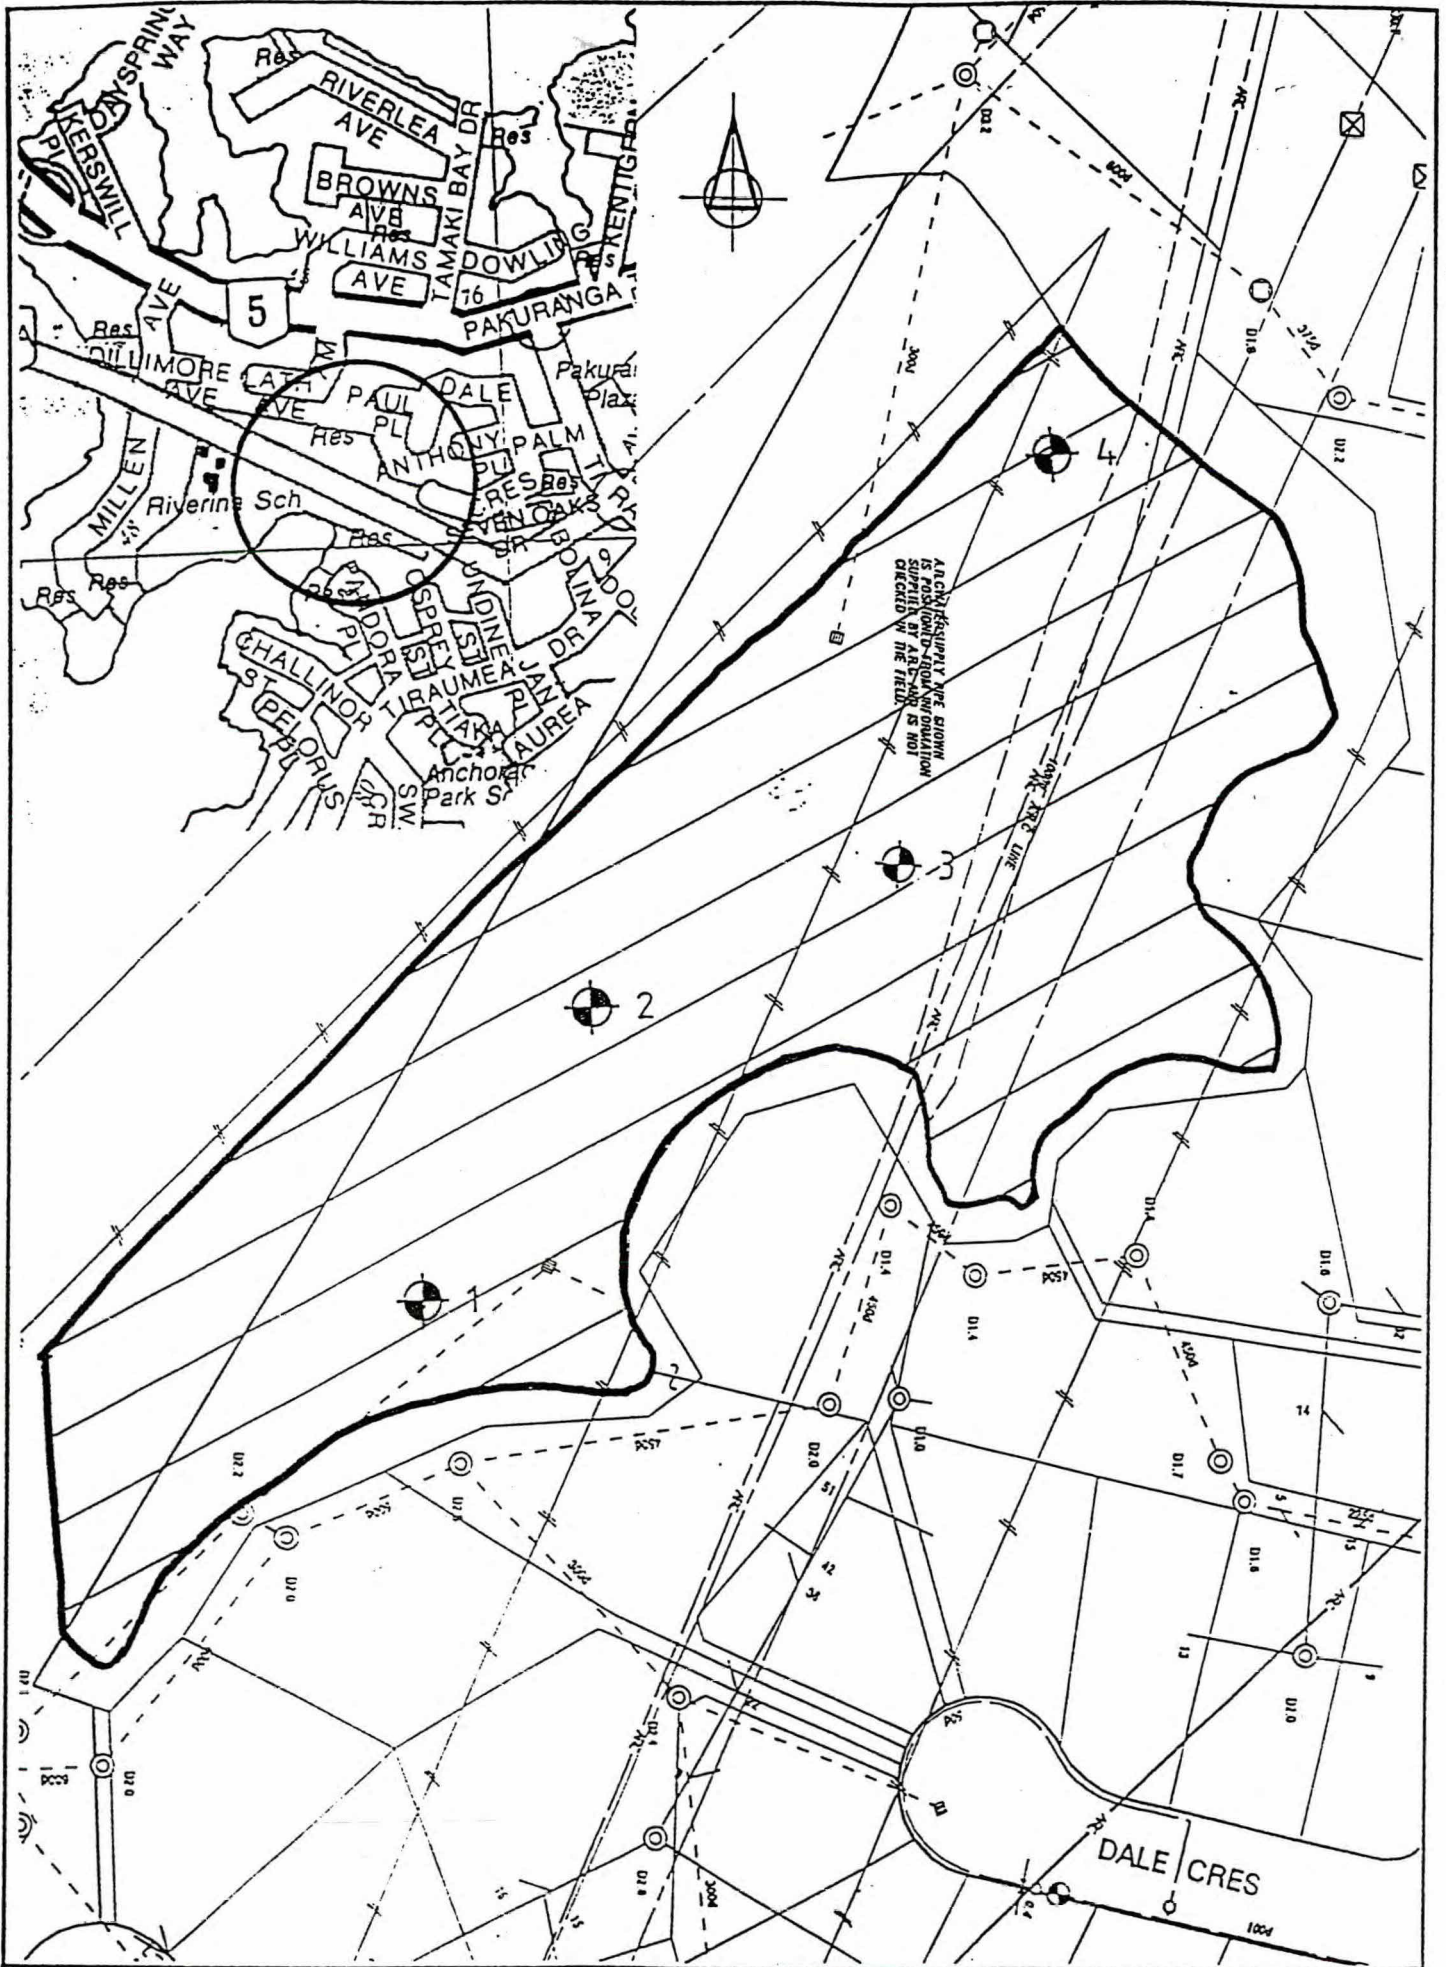

MANUKAU CONSULTANTS
 Consulting Civil & Structural Engineers, Contracted Lab, Project Management, Contract Documentation & Supervision, Surveying.
 Telephone (09) 267 8111 Fax (09) 262 5113

DALE CRESENT WATER SAMPLING LOCATIONS

REV (M)

REV	DATE	BY	CHKD


NO.	DESCRIPTION	DATE
DRAWN	D Lender	02/10
CHECKED	A Robinson	02/10
PL. APPROVED		

PLAN NO 9

Bik. 92. 7P
~~83~~ ~~83~~ ~~26a~~
01 95

Lot 34
DP 99764
2330 m²
Δ ✓

Lot 37
DP 99763
5130 m²
x

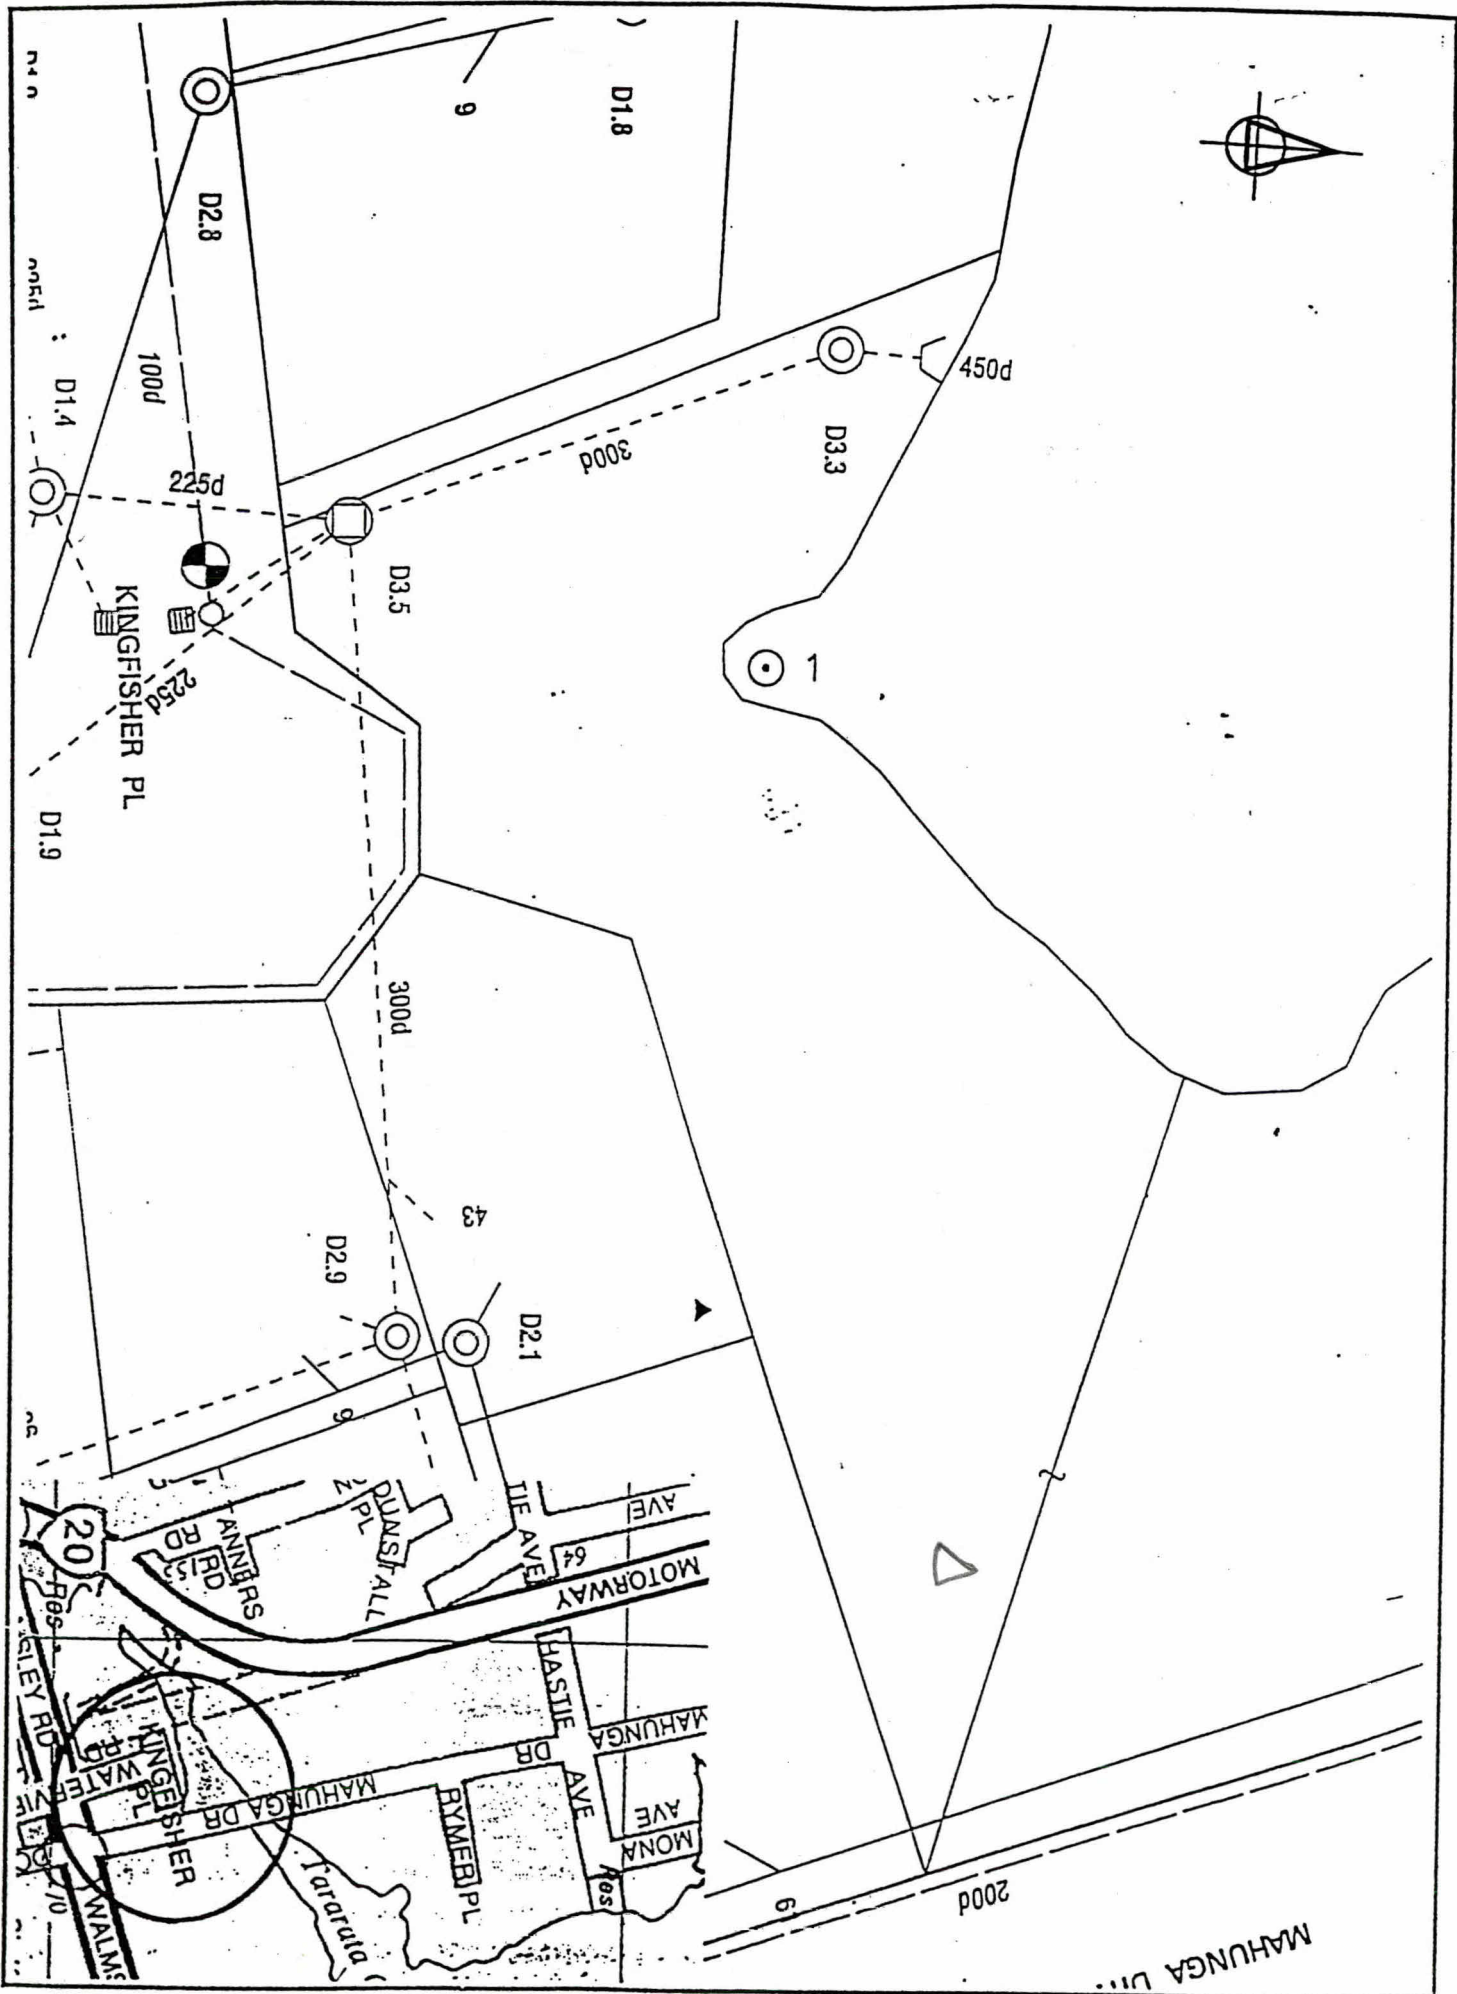

MANUKAU CONSULTANTS
 Consulting Civil & Structural Engineers, Construction Ltd.
 Project Management, Contract Documentation & Supervision, Surveying.
 Telephone (06) 262 8699
 Fax (06) 262 8131

TITLE
KINGFISHER PLACE WATER SAMPLING LOCATIONS

REV CHK

	SIGNED	DATE
DRAWN	D. Lander	07/11
CHECKED	A. Robinson	07/11
PLC. APPROVED		
PLAN NO.		

B/K
09

Sh.
~~15, 16, 20, 29, 30, 31~~

70
302 316
449


68R

ALLOT 101

SD 42279 Parish Papakuma.
1.2788 ha.

Δ ✓

Ammer

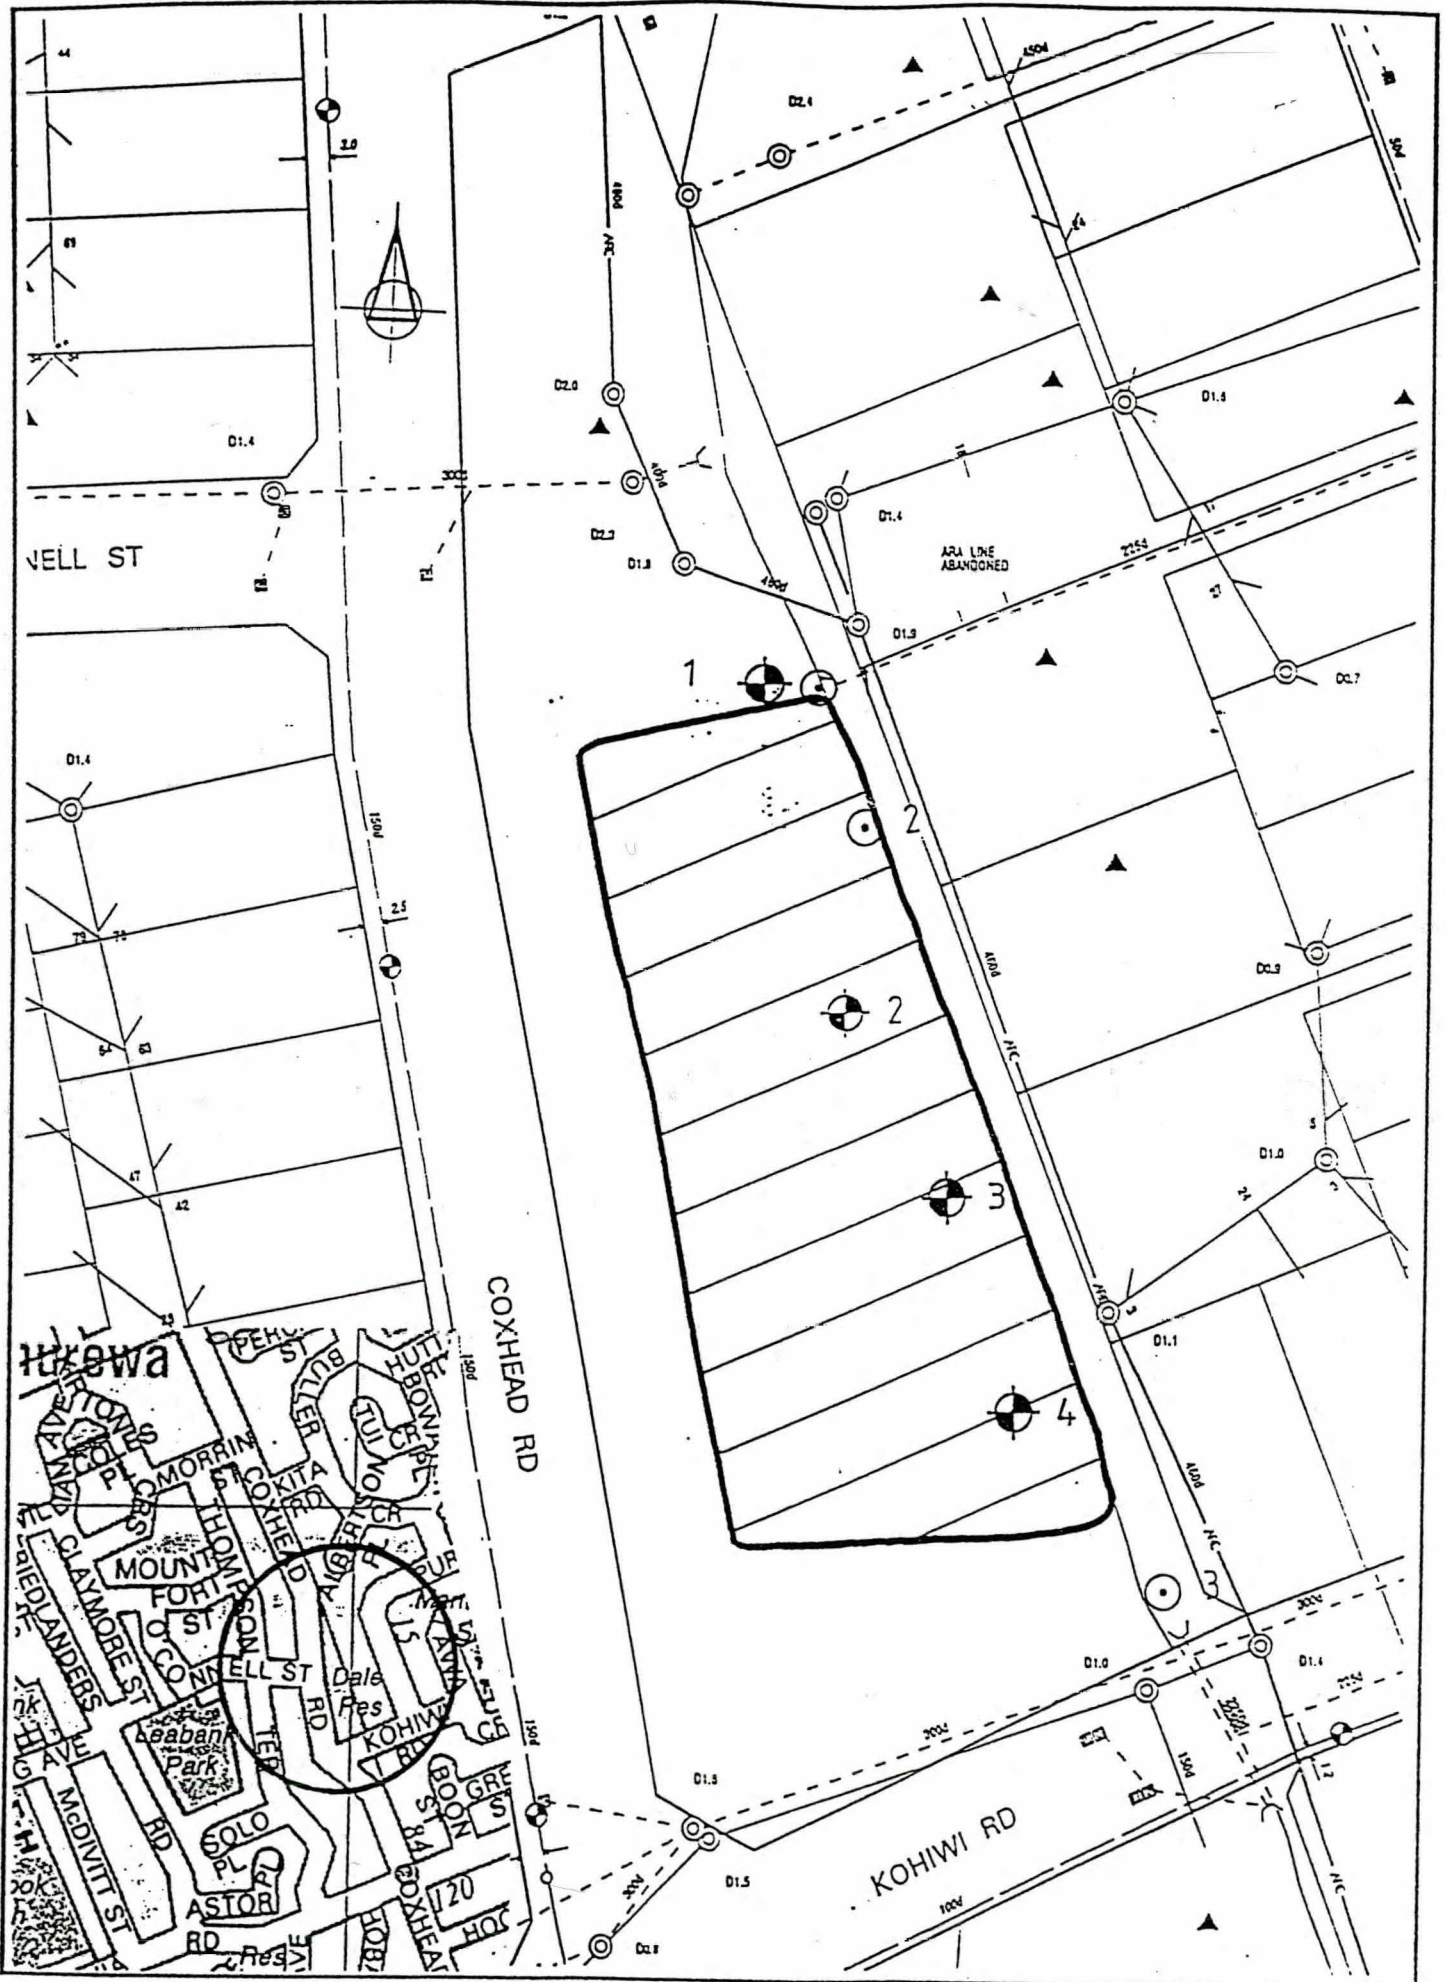

MANUKAU
CONSULTANTS
 Consulting Civil & Structural Engineers, Geotechnical Ltd, Project Management, Contract Documentation & Supervision, Surveying.
 Telephone (09) 242 8991
 Fax (09) 242 8131

TITLE
COXHEAD ROAD
WATER SAMPLING LOCATIONS

REV C/PK

	SCALE	DATE
DRAWN	G. Lender	07/10
CHECKED	A. Robinson	07/10
M.C. APPROVED		
PLAN NO 11		

B/K.
02

SL.
41, 42, 43
~~51, 52, 53, 63~~

70
7a, 7b, 7c
8a

490

Lot 1 NP 156506

20.9500ha.

X

(A next section)
Pt. Allot 78A
9422m² ?


Blk. Sh. 16d.
03 72
04 61 72

Allot 523
SO 55438 Parish of Manurewa.
813 m² Δ ✓

Allot 540
SO 55438
450 m² Δ ✓

blk. sk. TP
07 26 36c, 37a

Allot 386
SD 49436 Perish at Pa Kuranga.
2011m² Δ ✓

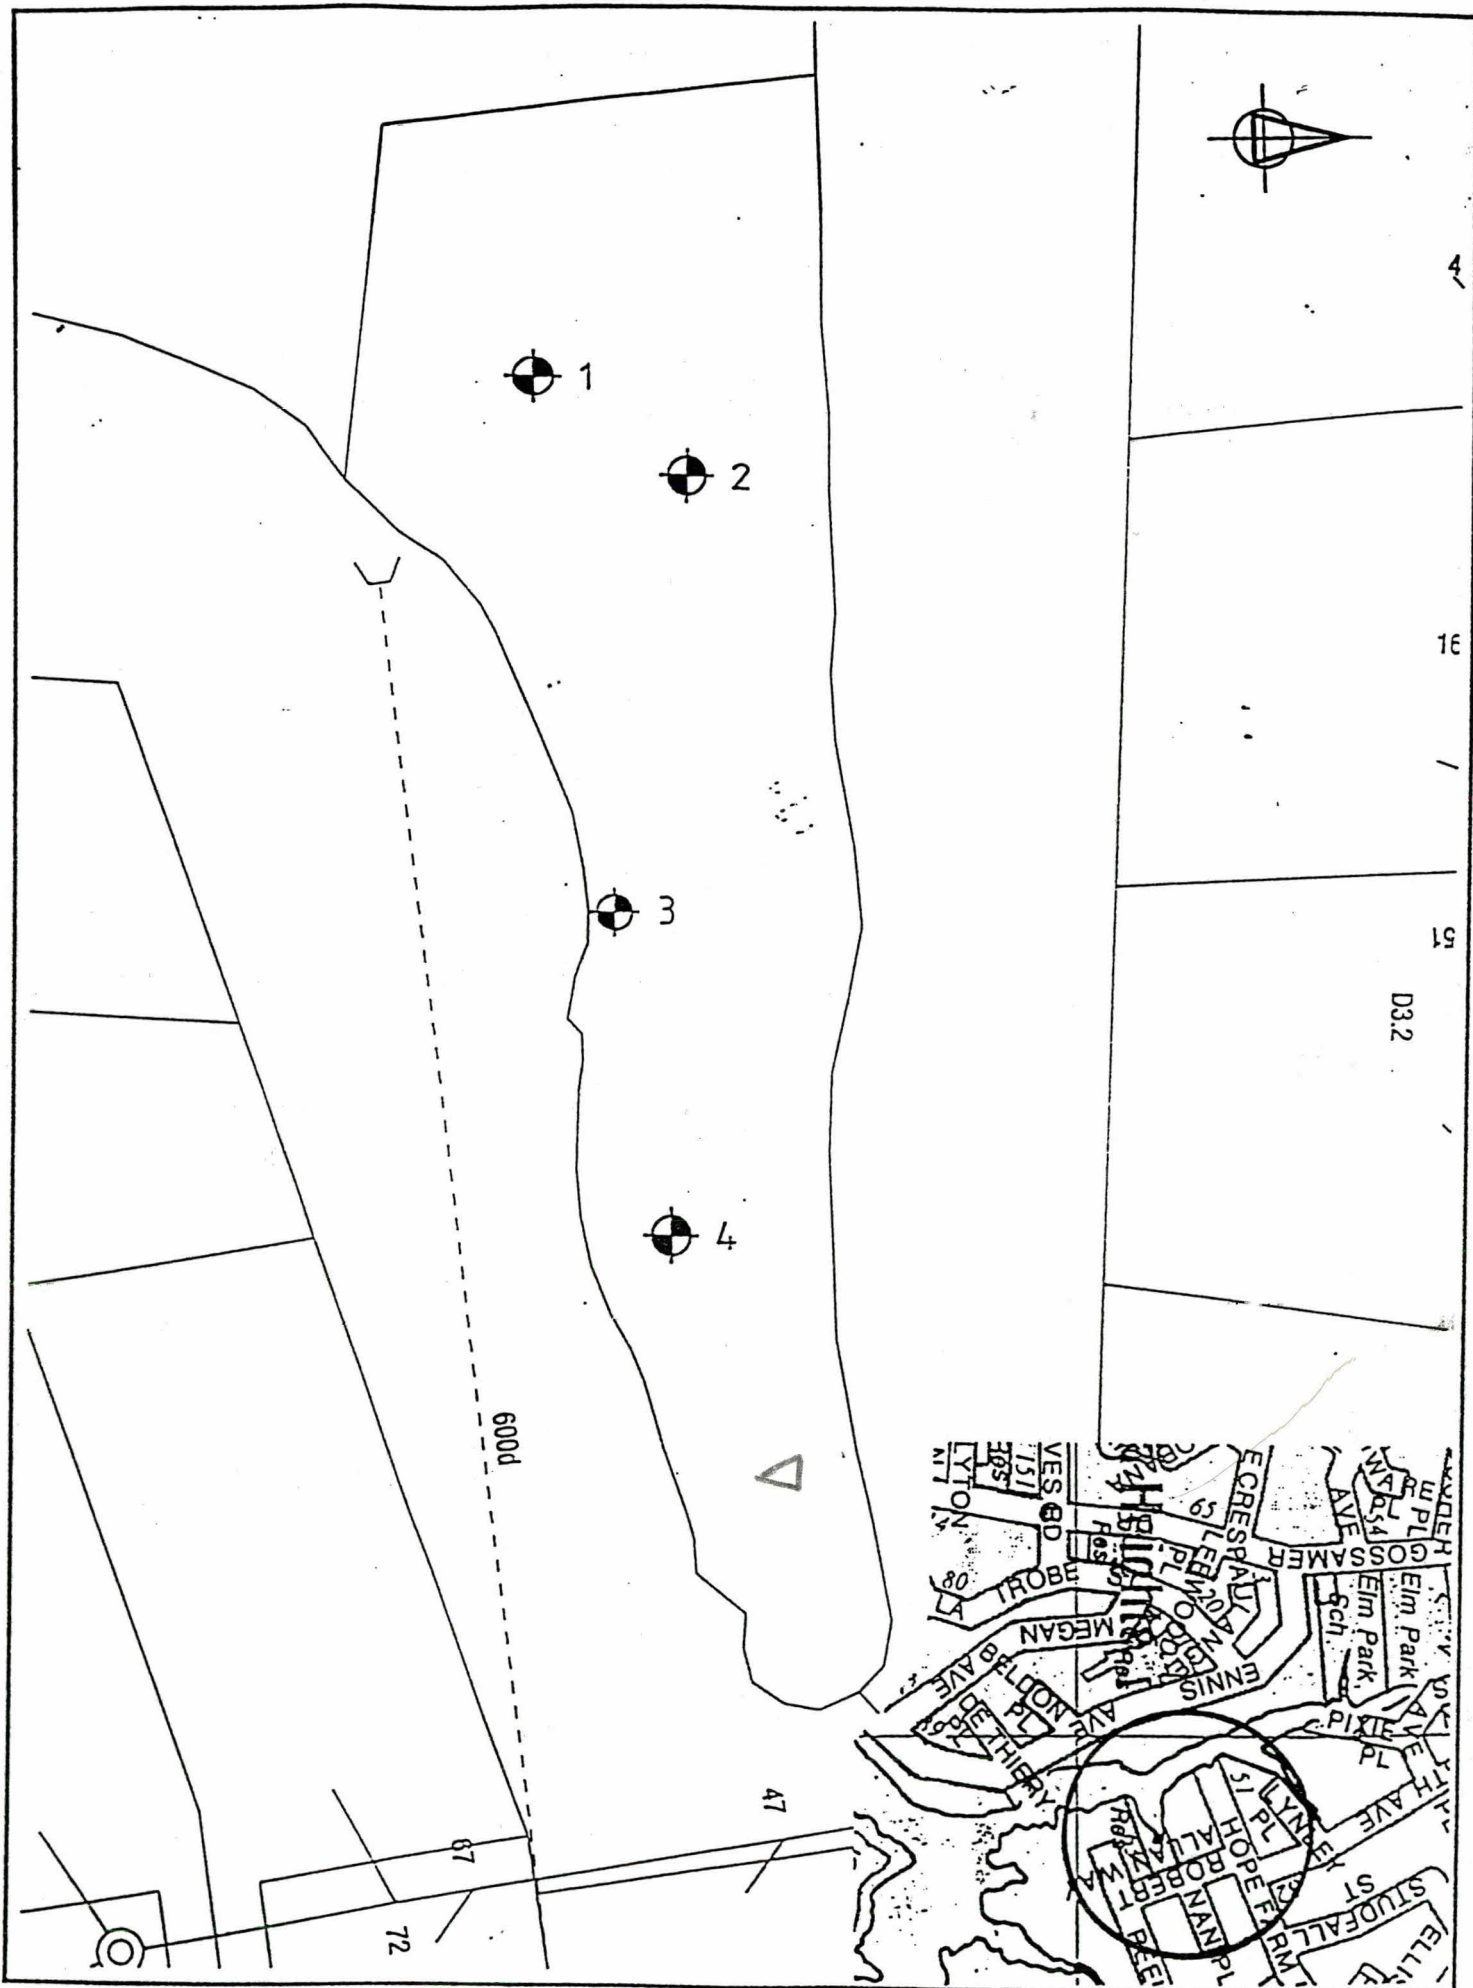

MANUKAU
CONSULTANTS
 Consulting Civil & Structural
 Engineers,
 Geotechnical Ltd,
 Project Management,
 Contract Administration
 & Supervision,
 Surveying.
 Telephone (09) 262 8999

TITLE
**ROBERT ALLAN ROAD
 WATER SAMPLING LOCATIONS**

REV CHG

	SCALE	DATE
DRAWN	D. Lender	07/11
CHECKED	A. Robinson	07/11
P.L. APPROVED		


B/K. Sk. TP
04 ~~68,69~~ 18d.

①

Pt Lot 1
DP 28051
2033m²
Δ ✓

②

SW motorway. X

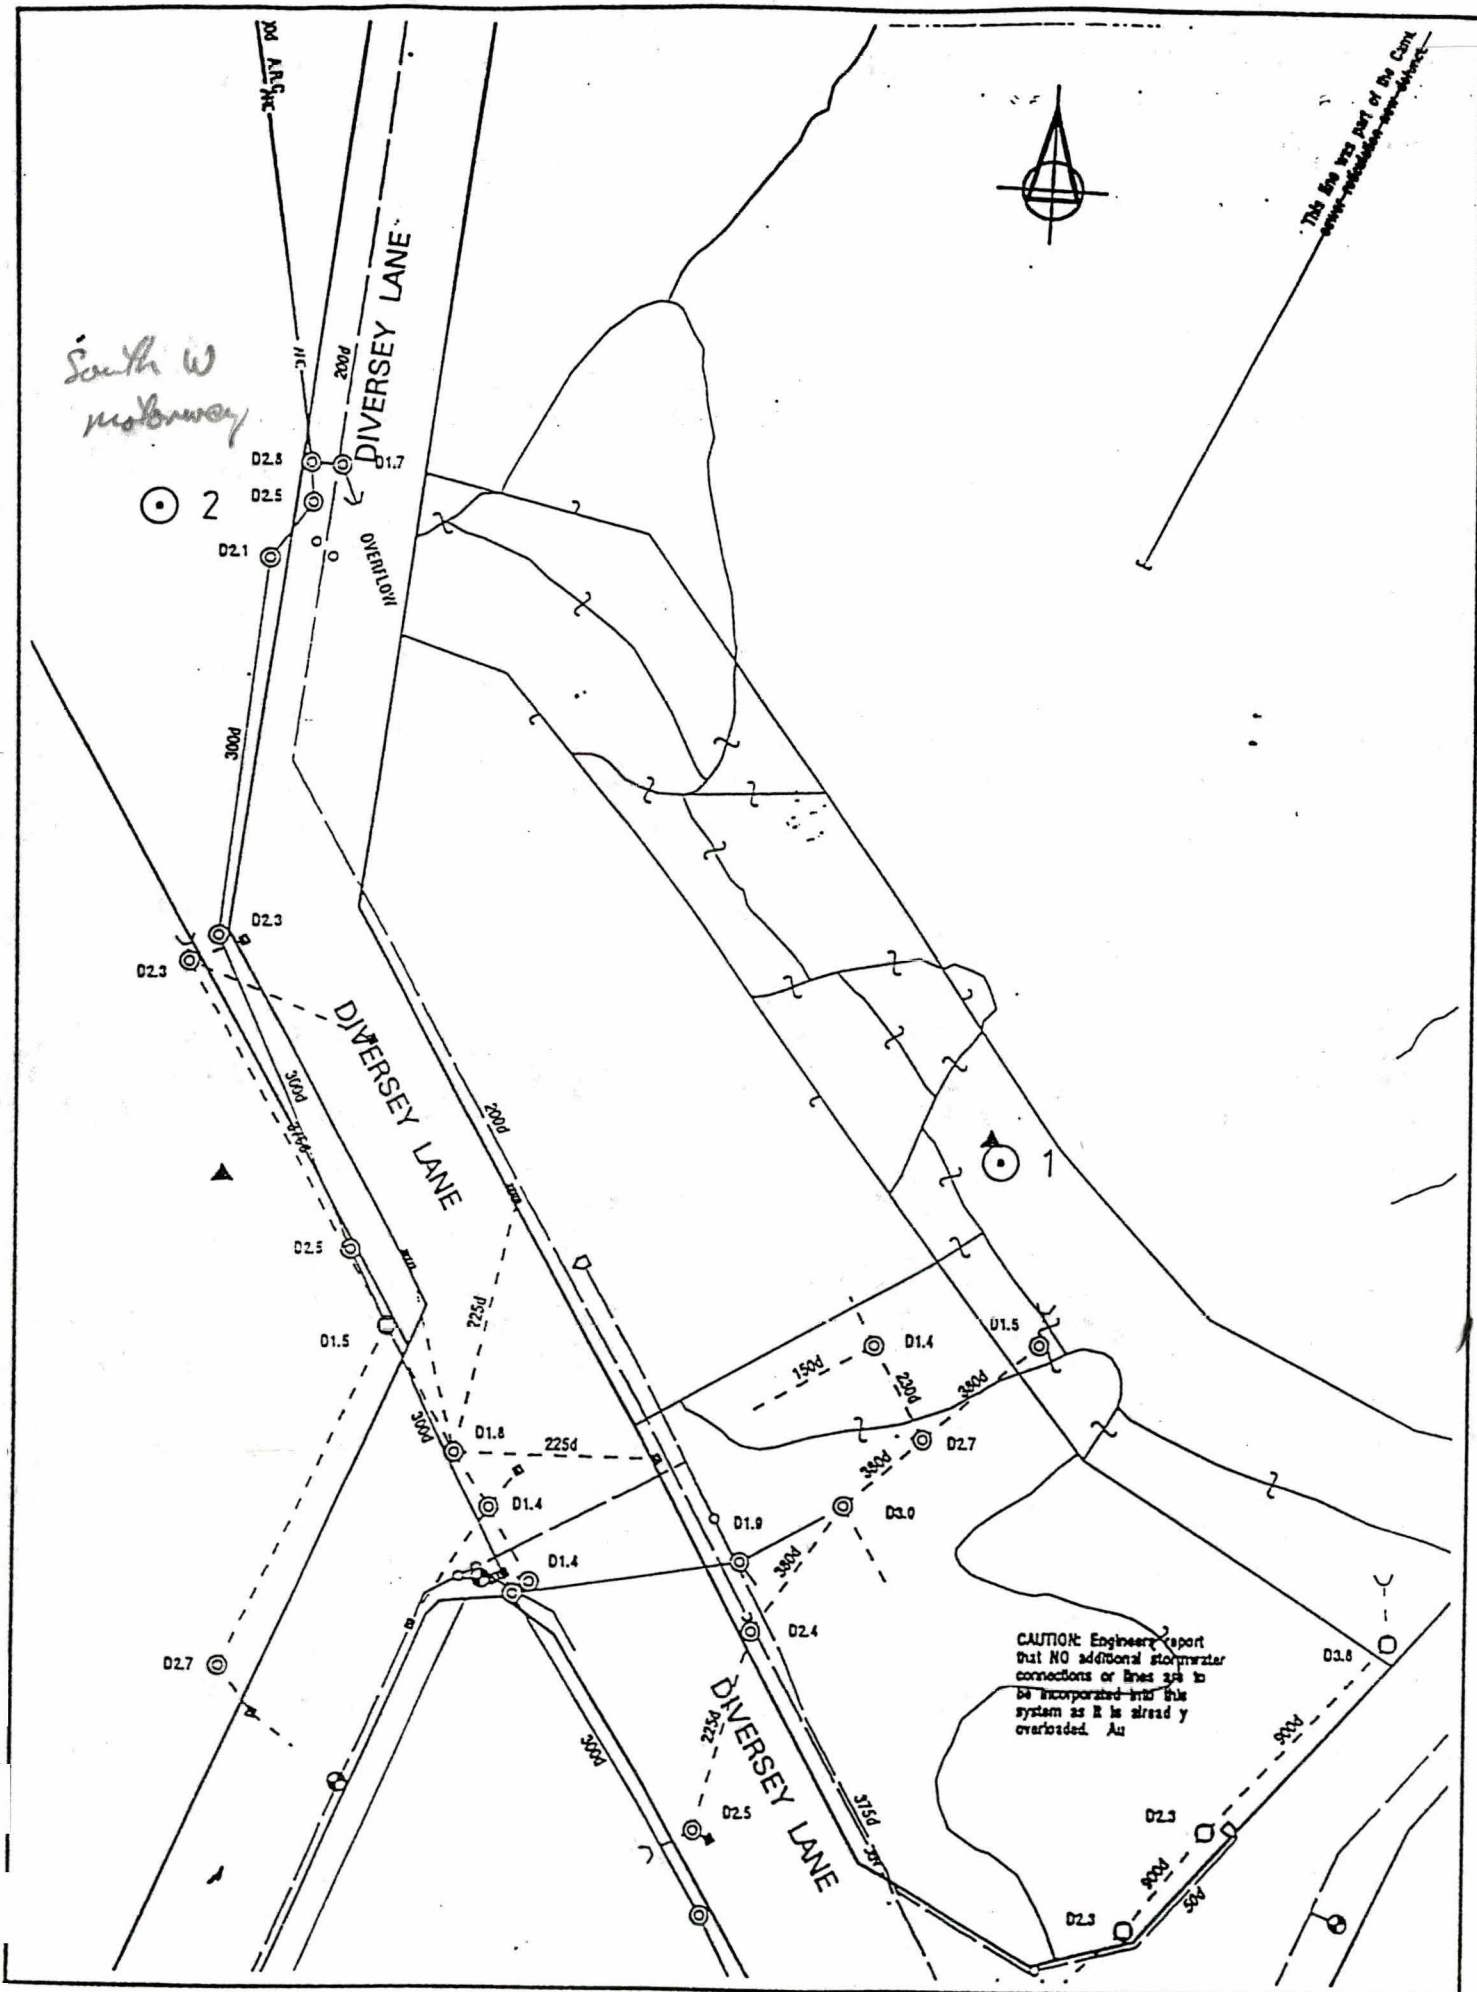

MANUKAU
CONSULTANTS
 CONSULTANTS LIMITED
 Consulting Civil & Structural Engineers, Geotechnical Ltd., Project Management, Contract Documentation & Supervision, Surveying.
 Telephone (09) 242 0999
 Fax (09) 242 3131

TITLE
ROSCOMMON ROAD
WATER SAMPLING LOCATIONS

REV. ENH

	SIGNED	DATE
DRAWN	D. Lander	02/11
CHECKED	A. Robinson	02/11
M.C. APPROVED		
DATE		


RECEIVED: 26 Sep 2012 SCANNED: 26 Sep 2012 BOX: 52 BATCH: 96494 DOC: ACLAAOZA

DATE	SCALE	DRAWN	CHECKED	HL APPROVED
07/78		D. Linder	A. Robinson	
07/78				

TIRAUMA RESERVE
WATER SAMPLING LOCATIONS

FILE

CONSULTANTS
MANKAU
Engineering, Design & Construction
Civil Engineering
Water Management
Construction Ltd.
Tirama (08) 282 2822
Surveying

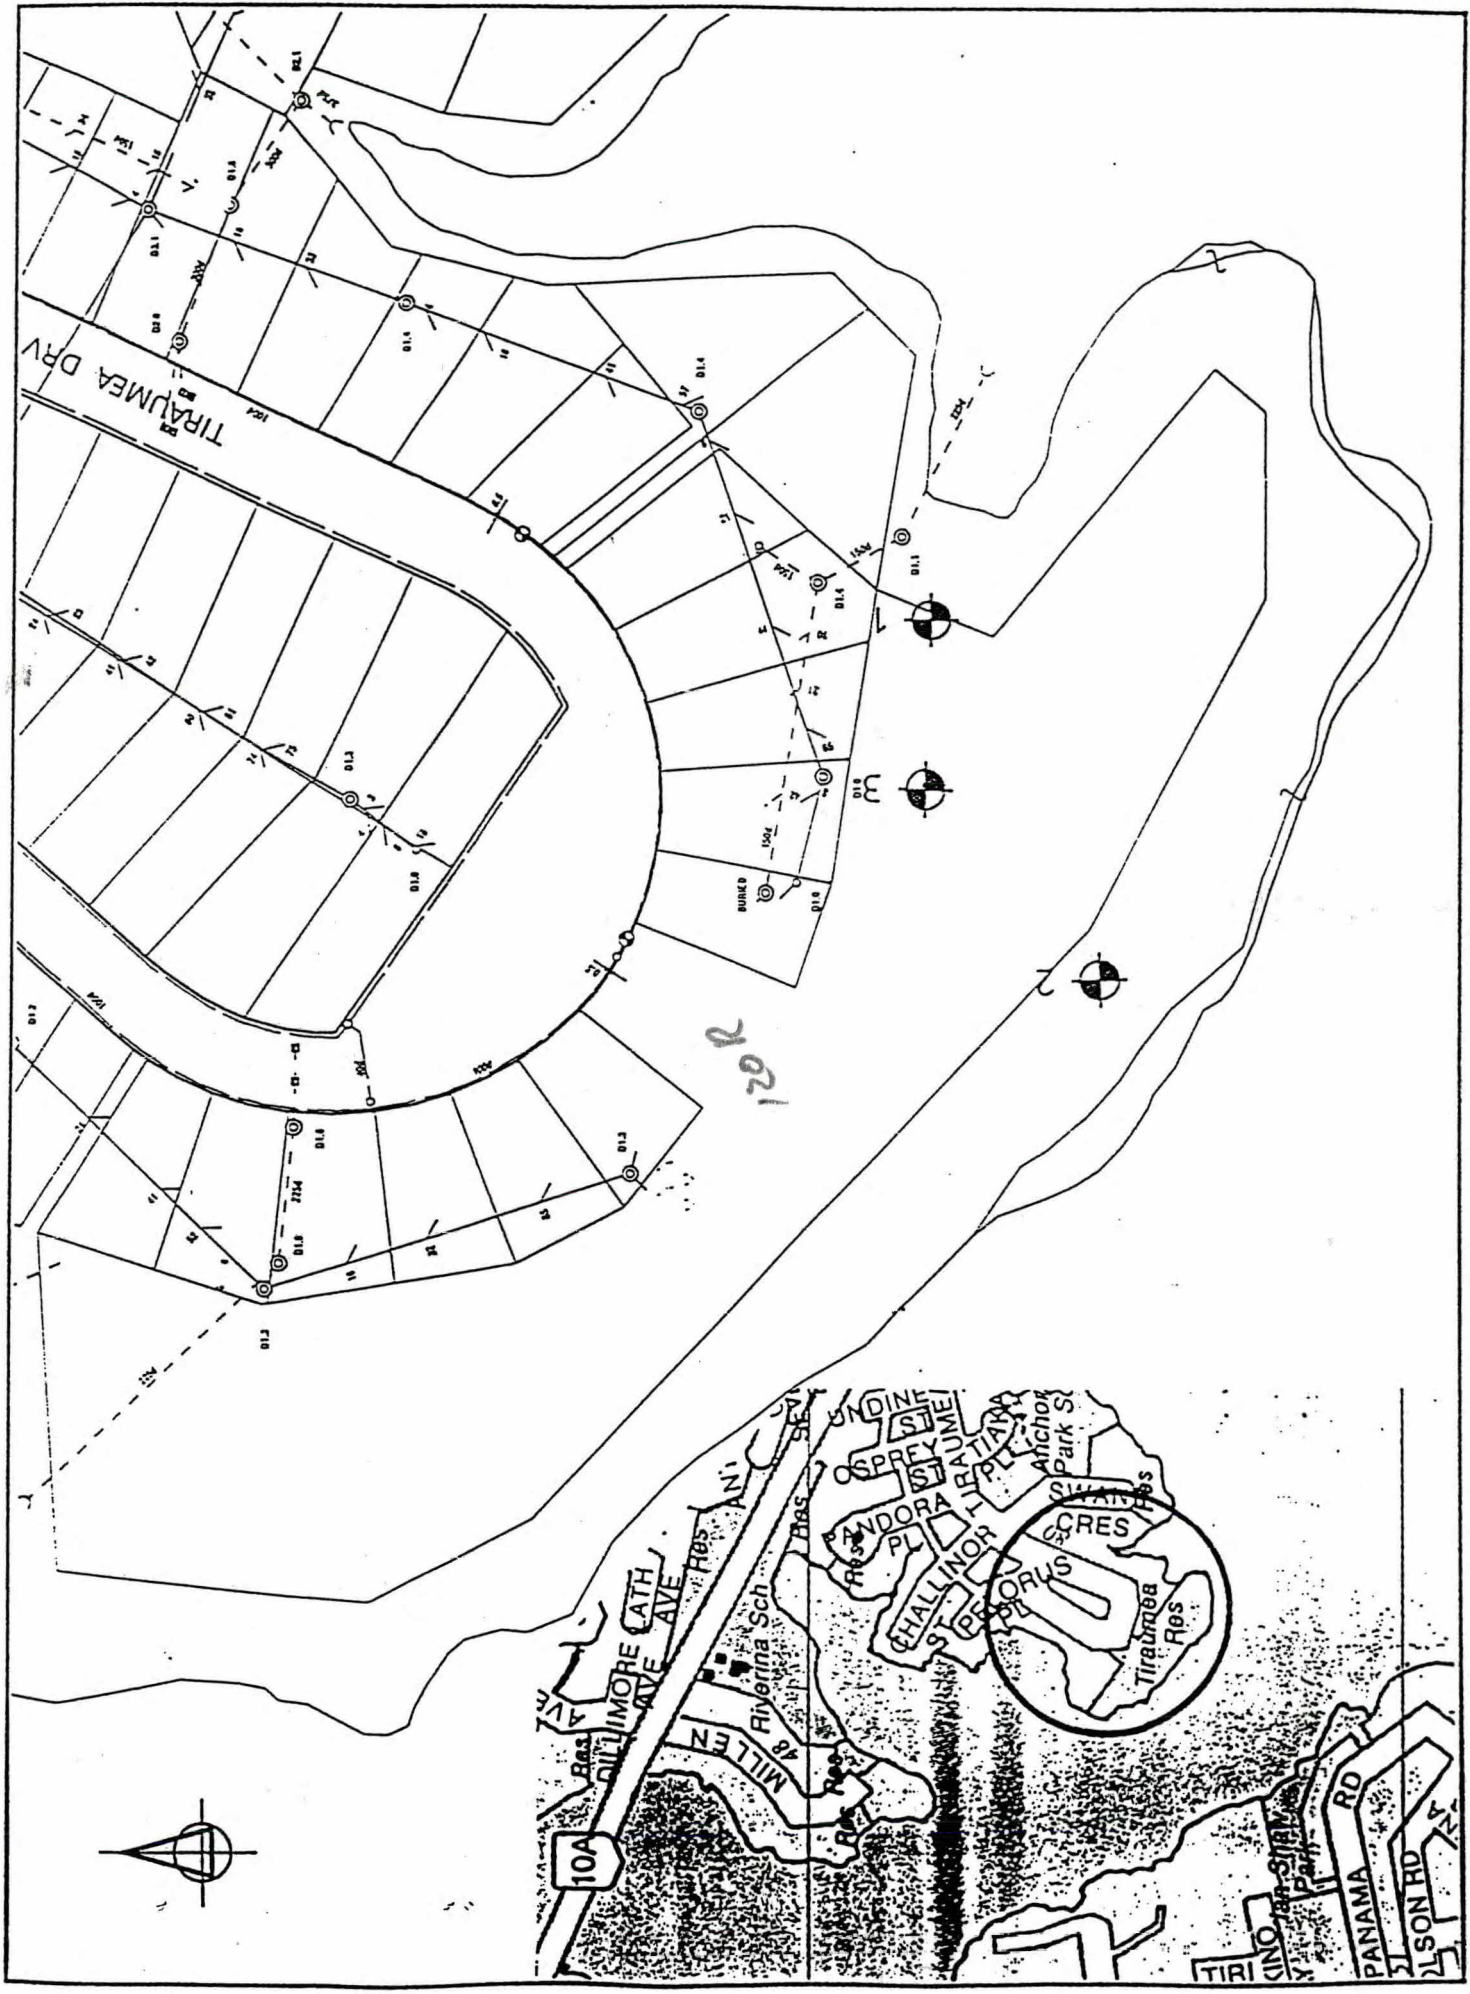

BKK. Sh.

TP

01 ~~80, 81, 82, 83~~

10c, 11a, 5b, 5d

~~94, 95~~


Allot 218

SO 59 109

Suburbs of Mangrove.

1.1600 ha.

Δ ✓

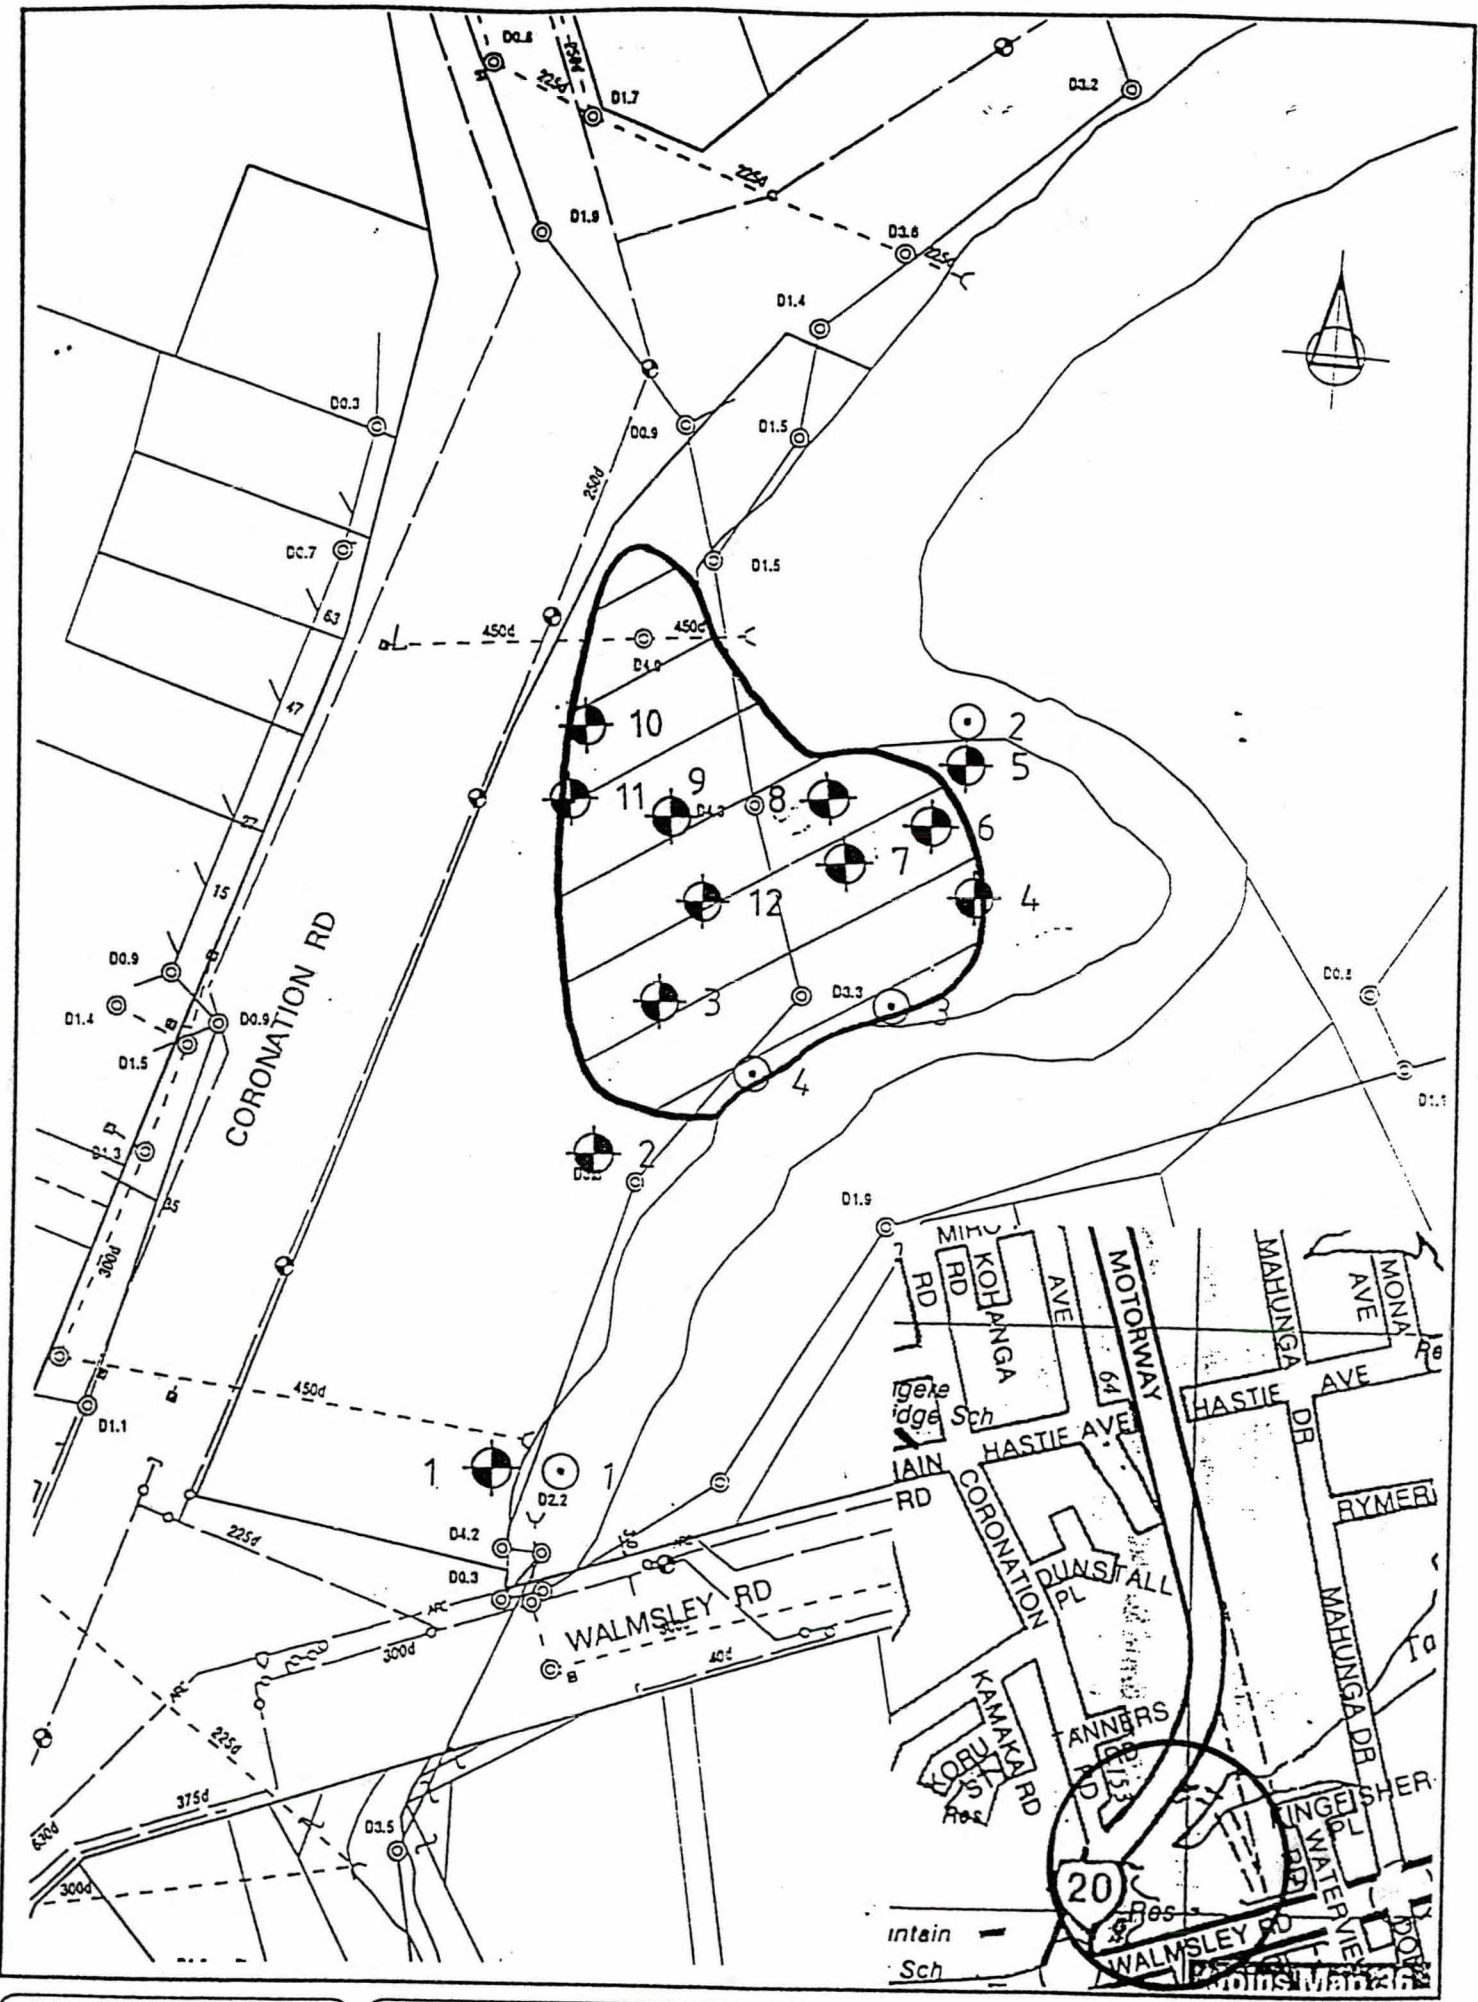

MANUKAU

CONSULTANTS

Consulting Civil & Structural
 Engineers,
 Geotechnical Ltd.
 Project Management,
 Contract Documentation
 & Supervision,
 Surveying.

Telephone (09) 262 8099
 Fax (09) 262 8131

TITLE

**OLD QUARRY ROAD
 WATER SAMPLING LOCATIONS**

REV CHX

	SIGNED	DATE
DRAWN	D. Linder	02/98
CHECKED	A. Robinson	02/98
PLC APPROVED		
REV	DI AM NO 47	

Δ ✓

3546 m²

DP 57254


LS 279


74R

23d, 246
H

~~14, 576~~
SK

Bik. 07

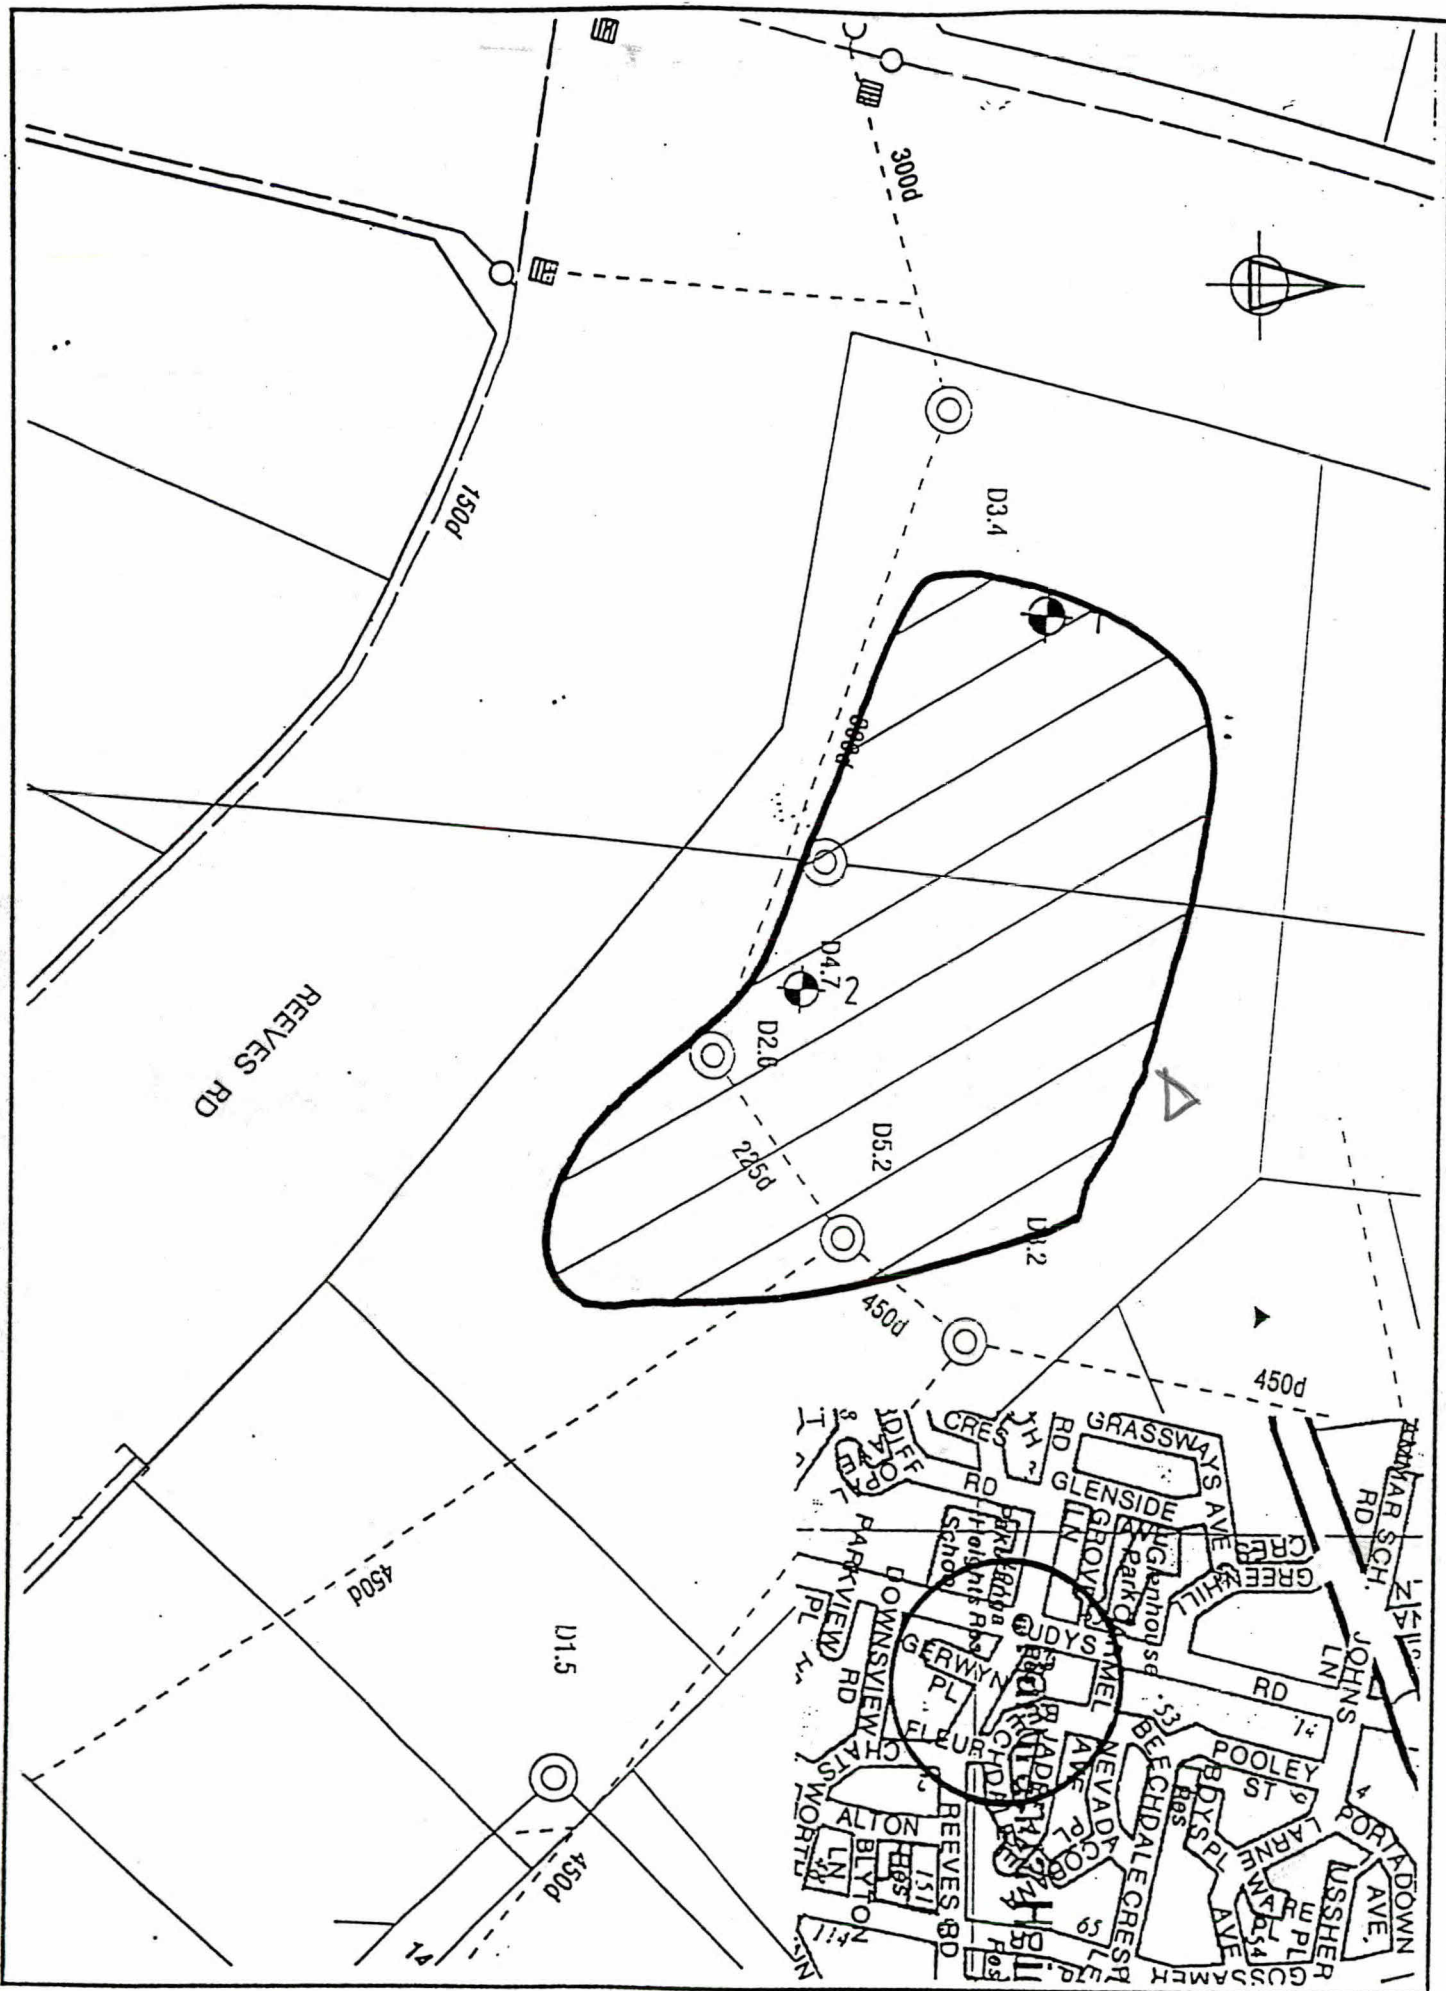

MANDAKAU

CONSULTANTS LIMITED
 Consulting Civil & Structural Engineers,
 Geotechnical Lab,
 Project Management,
 Contract Documentation & Supervision,
 Surveying.
 Telephone (08) 262 8818
 Fax (08) 262 8121

TITLE
UDYS ROAD
WATER SAMPLING LOCATIONS
 REV DOR

SCALE:		DATE:
DRAWN	D. Lander	02/10
CHECKED	A. Robinson	02/11
K.L. APPROVED		
PLAN NO. 19		

Roof Reserve
Norman Rd X

Lot 1
DP 88781
2.1865 ha

X

Lot 26
DP 22801
1290 m²

X

Bik. 03
21.22
TR 100